



BEGIN SLIP RAMP D
PC STA. DS 1+000.000 =
PC STA. AS 1+000.000=
POT STA. VT 1+438.235, 10.579 m LT.

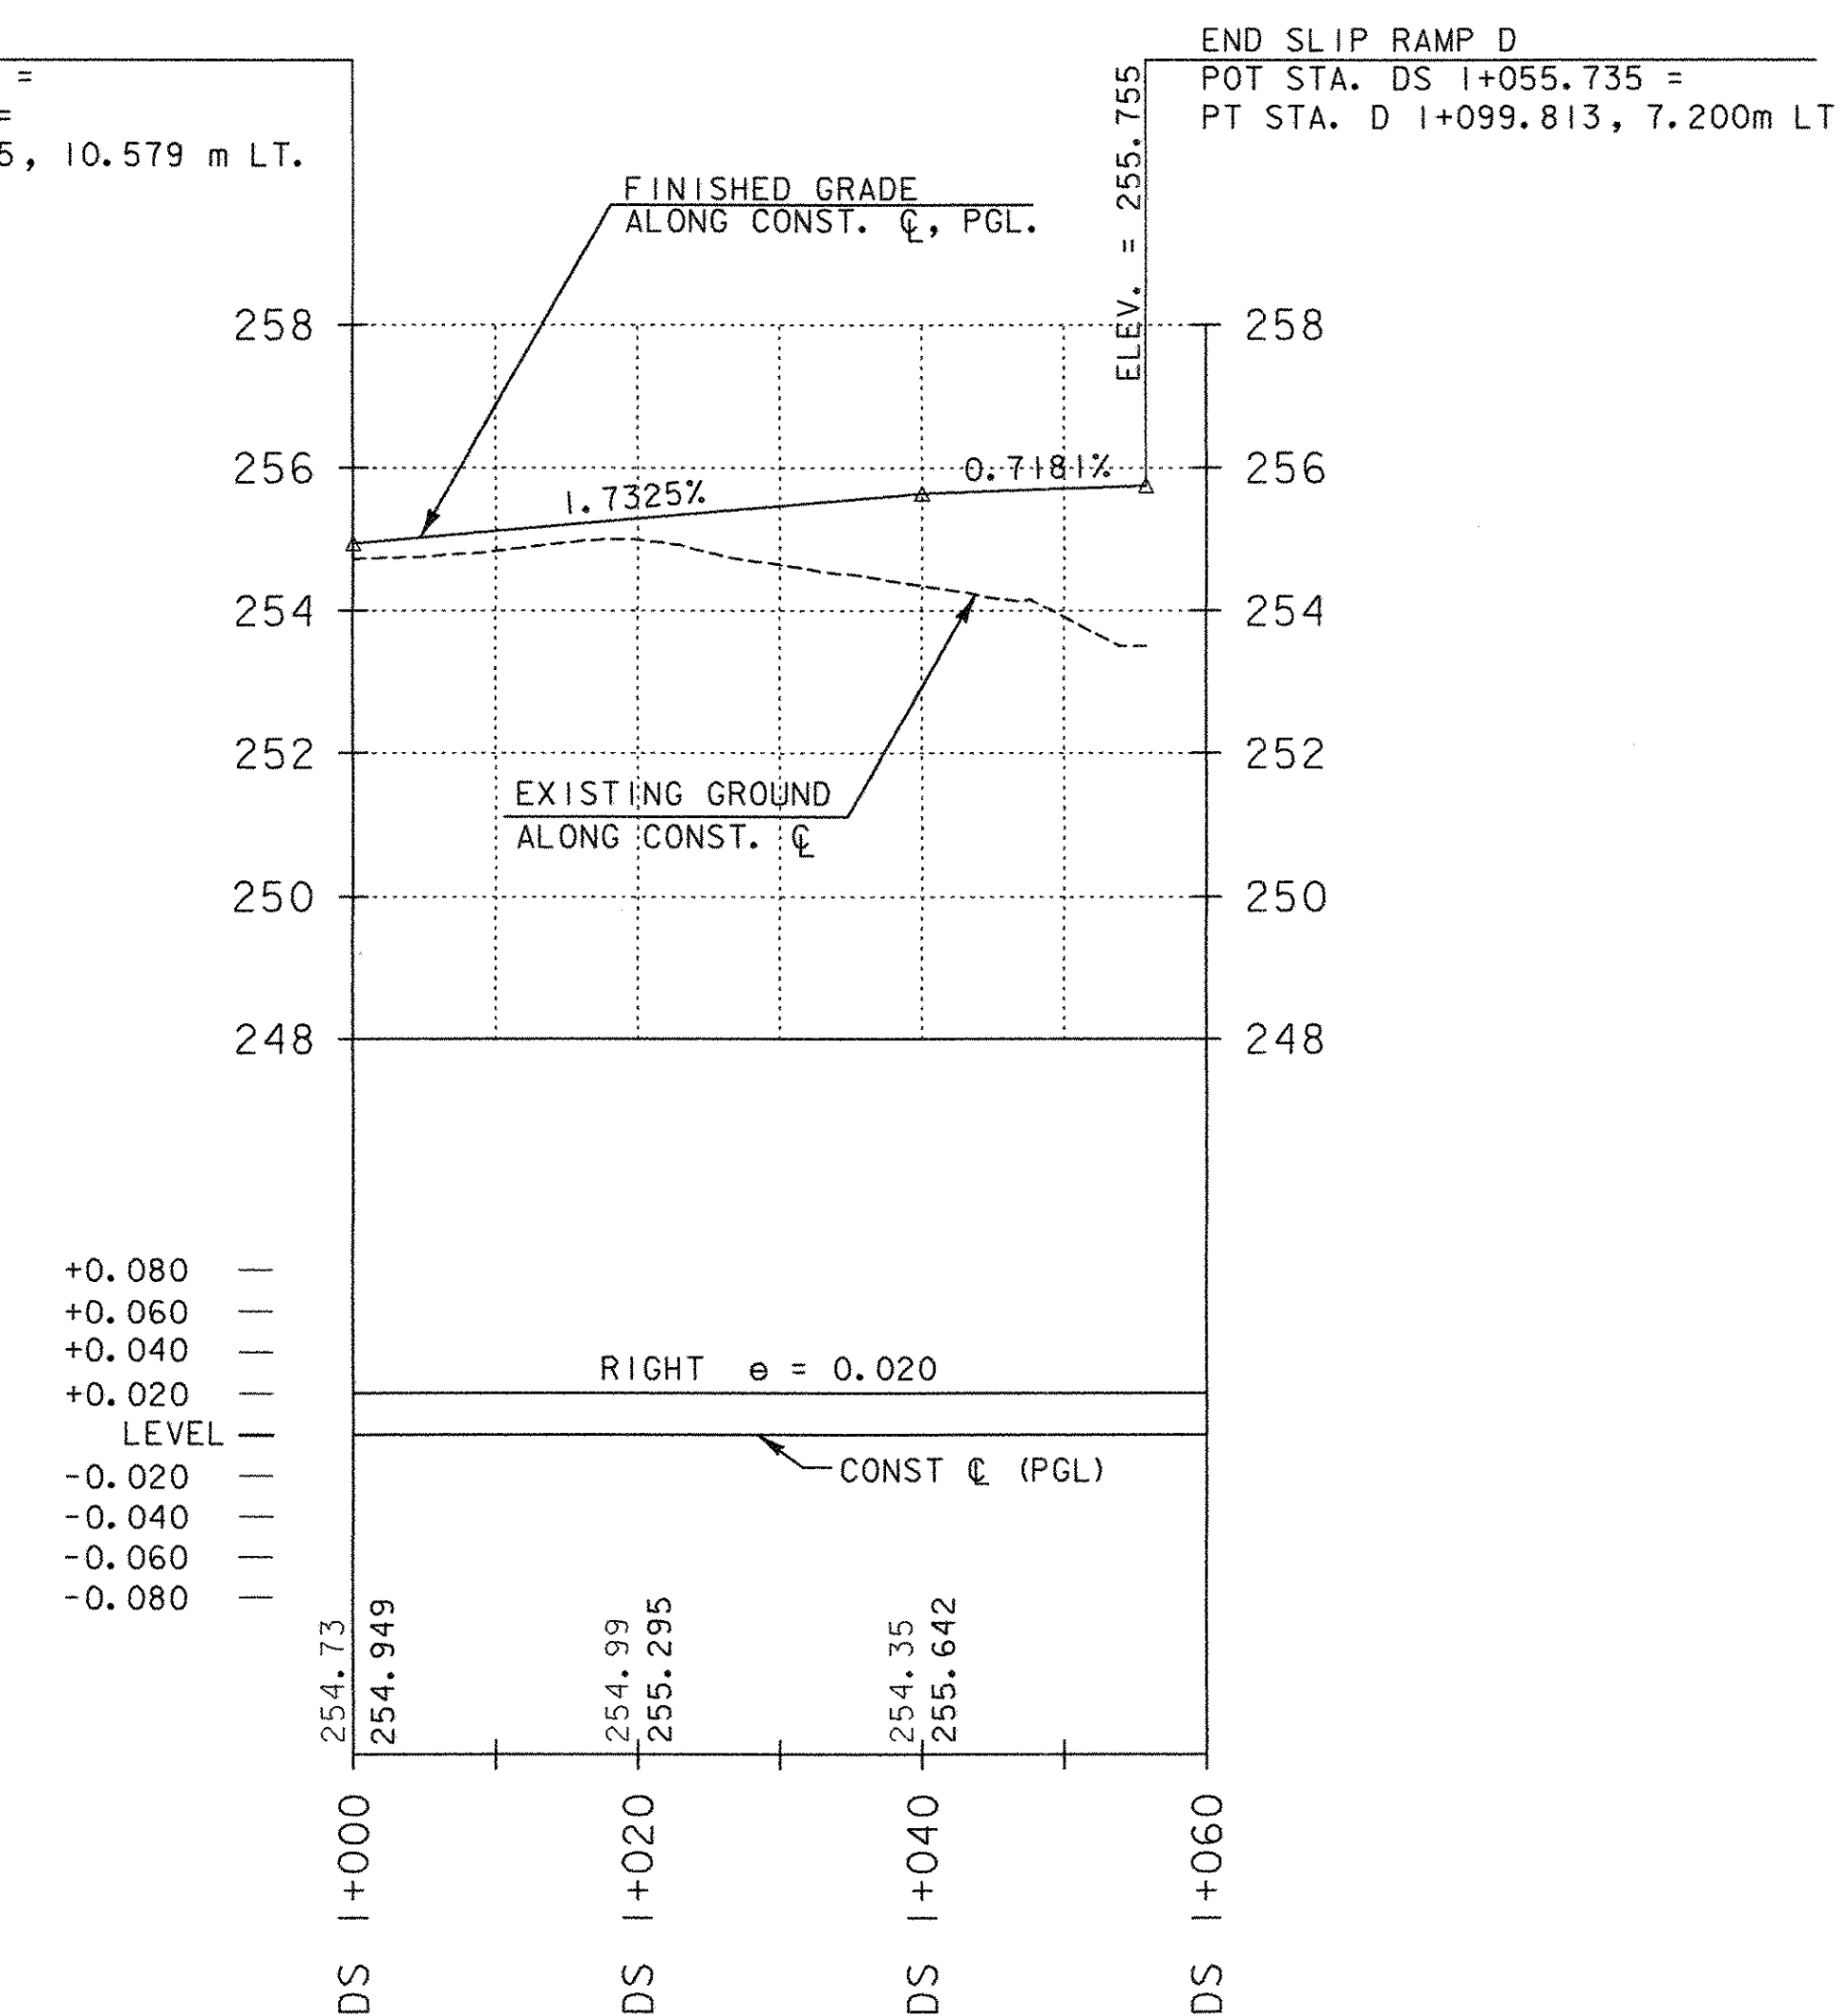

v:\1953\active\1953\002\transportation\drawing\contract\1\plot_files\z4307\pro_ramp.dptf

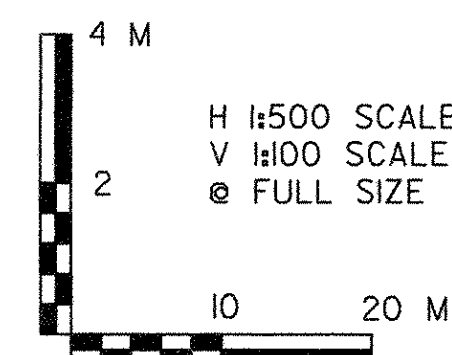

VERMONT AGENCY OF TRANSPORTATION



PROJECT NAME: BENNINGTON
PROJECT NUMBER: AC NH 019-(K51)

FILE NAME: ...z4307\pro_ramp.dptf
DESIGN SUPERVISOR: GREG EDWARDS
DESIGNED BY: MARC FOISY

PLOT DATE: 2/2/2009
DRAWN BY: STANTEC
CHECKED BY: GARY SANTY
SHEET 61 OF 367

RAMP D - PR-06