


v:\B53\active\B5310002\transportation\drawing\contract\1\plot_files\z307\bro_ramp_d.dwg

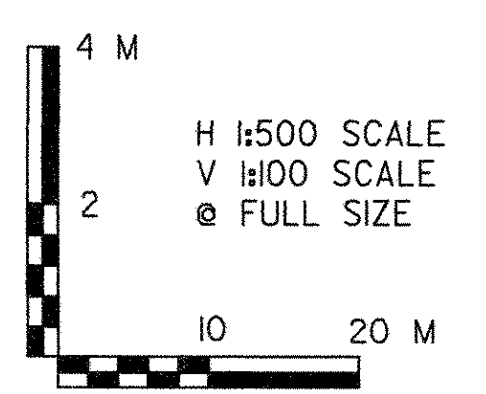

VERMONT AGENCY OF TRANSPORTATION	
	PROJECT NAME: BENNINGTON PROJECT NUMBER: AC NH 019-1(51)
	FILE NAME: ...z307\bro_ramp_d.dwg DESIGN SUPERVISOR: GREG EDWARDS DESIGNED BY: MARC FOISY
RAMP D - PR-07	