


- NOTES:
1. STA, D +460.000 - STA D +560.000 EXISTING GRADES SHOWN AS CONSTRUCTED UNDER PROJECT AC NH 019-1 (52)
 2. STA D +565.189 - STA D +580.000 FINISH GRADES ARE SHOWN 50 MM ABOVE EXISTING GRADES.
 3. SUPERELEVATION TO MATCH THE CROSS SLOPE AS CONSTRUCTED UNDER AC NH 019-1 (52)

NOTE: SUPERELEVATION TO MATCH THE CROSS SLOPE AS CONSTRUCTED UNDER AC NH 019-1 (52)



VERMONT AGENCY OF TRANSPORTATION

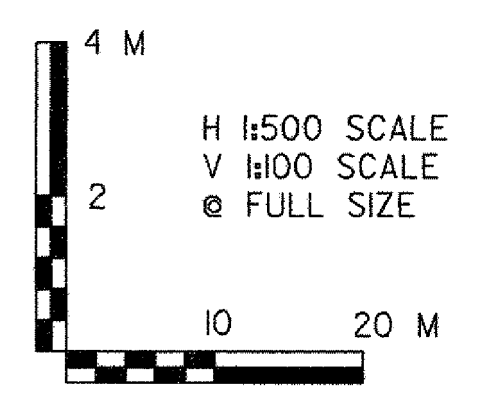

PROJECT NAME: BENNINGTON	PLOT DATE: 2/2/2009
PROJECT NUMBER: AC NH 019-1(51)	DRAWN BY: STANTEC
FILE NAME: ...zd307clpro_ramp.dptf	CHECKED BY: GARY SANTY
DESIGN SUPERVISOR: GREG EDWARDS	SHEET 63 OF 367
DESIGNED BY: MARC FOISY	
RAMP D - PR-08	

v:\1953\active\1953\002\transportation\drawing\contract\1\plot_files\z307clpro_ramp.dptf