

PORTLAND CEMENT CONCRETE SIDEWALK, 125mm

STA. VT 1+702.274, RT. (CONNECT EXISTING WALKWAY TO NEW SIDEWALK)

REMOVING AND RESETTING FENCE

STA. VT 1+700.000, 7.9m RT. - STA. VT 1+706.386, 12.4m RT. FENCE TO BE RESET TO JUST OUTSIDE OF CLEAR ZONE.

CONSTRUCT DRIVE

STA. VT 1+705.571, LT. (10.2m GRAVEL)
STA. VT 1+709.533, RT. (5.5m GRAVEL)
STA. VT 1+718.328, RT. (3.5m GRAVEL)
STA. VT 1+735.298, RT. (3.7m GRAVEL)
STA. VT 1+743.036, RT. (6.3m GRAVEL)
STA. VT 1+743.500, RT. (6.0m LINDEN STREET)
STA. VT 1+780.467, RT. (5.5m GRAVEL)
STA. VT 1+792.005, RT. (13.6m GRAVEL)

RELOCATE MAILBOX, SINGLE SUPPORT



STA. VT 1+713.970, RT.
STA. VT 1+723.500, RT.
STA. VT 1+729.500, RT.
STA. VT 1+777.919, RT.

RELOCATE MAILBOX, MULTIPLE SUPPORT

STA. VT 1+756.400, RT.

SOLID ROCK EXCAVATION

STA. VT 1+702.274, RT. (REMOVE CONC. WALK)
STA. VT 1+700.000 - STA. VT 1+820.000, (REMOVE CONCRETE ROADWAY)

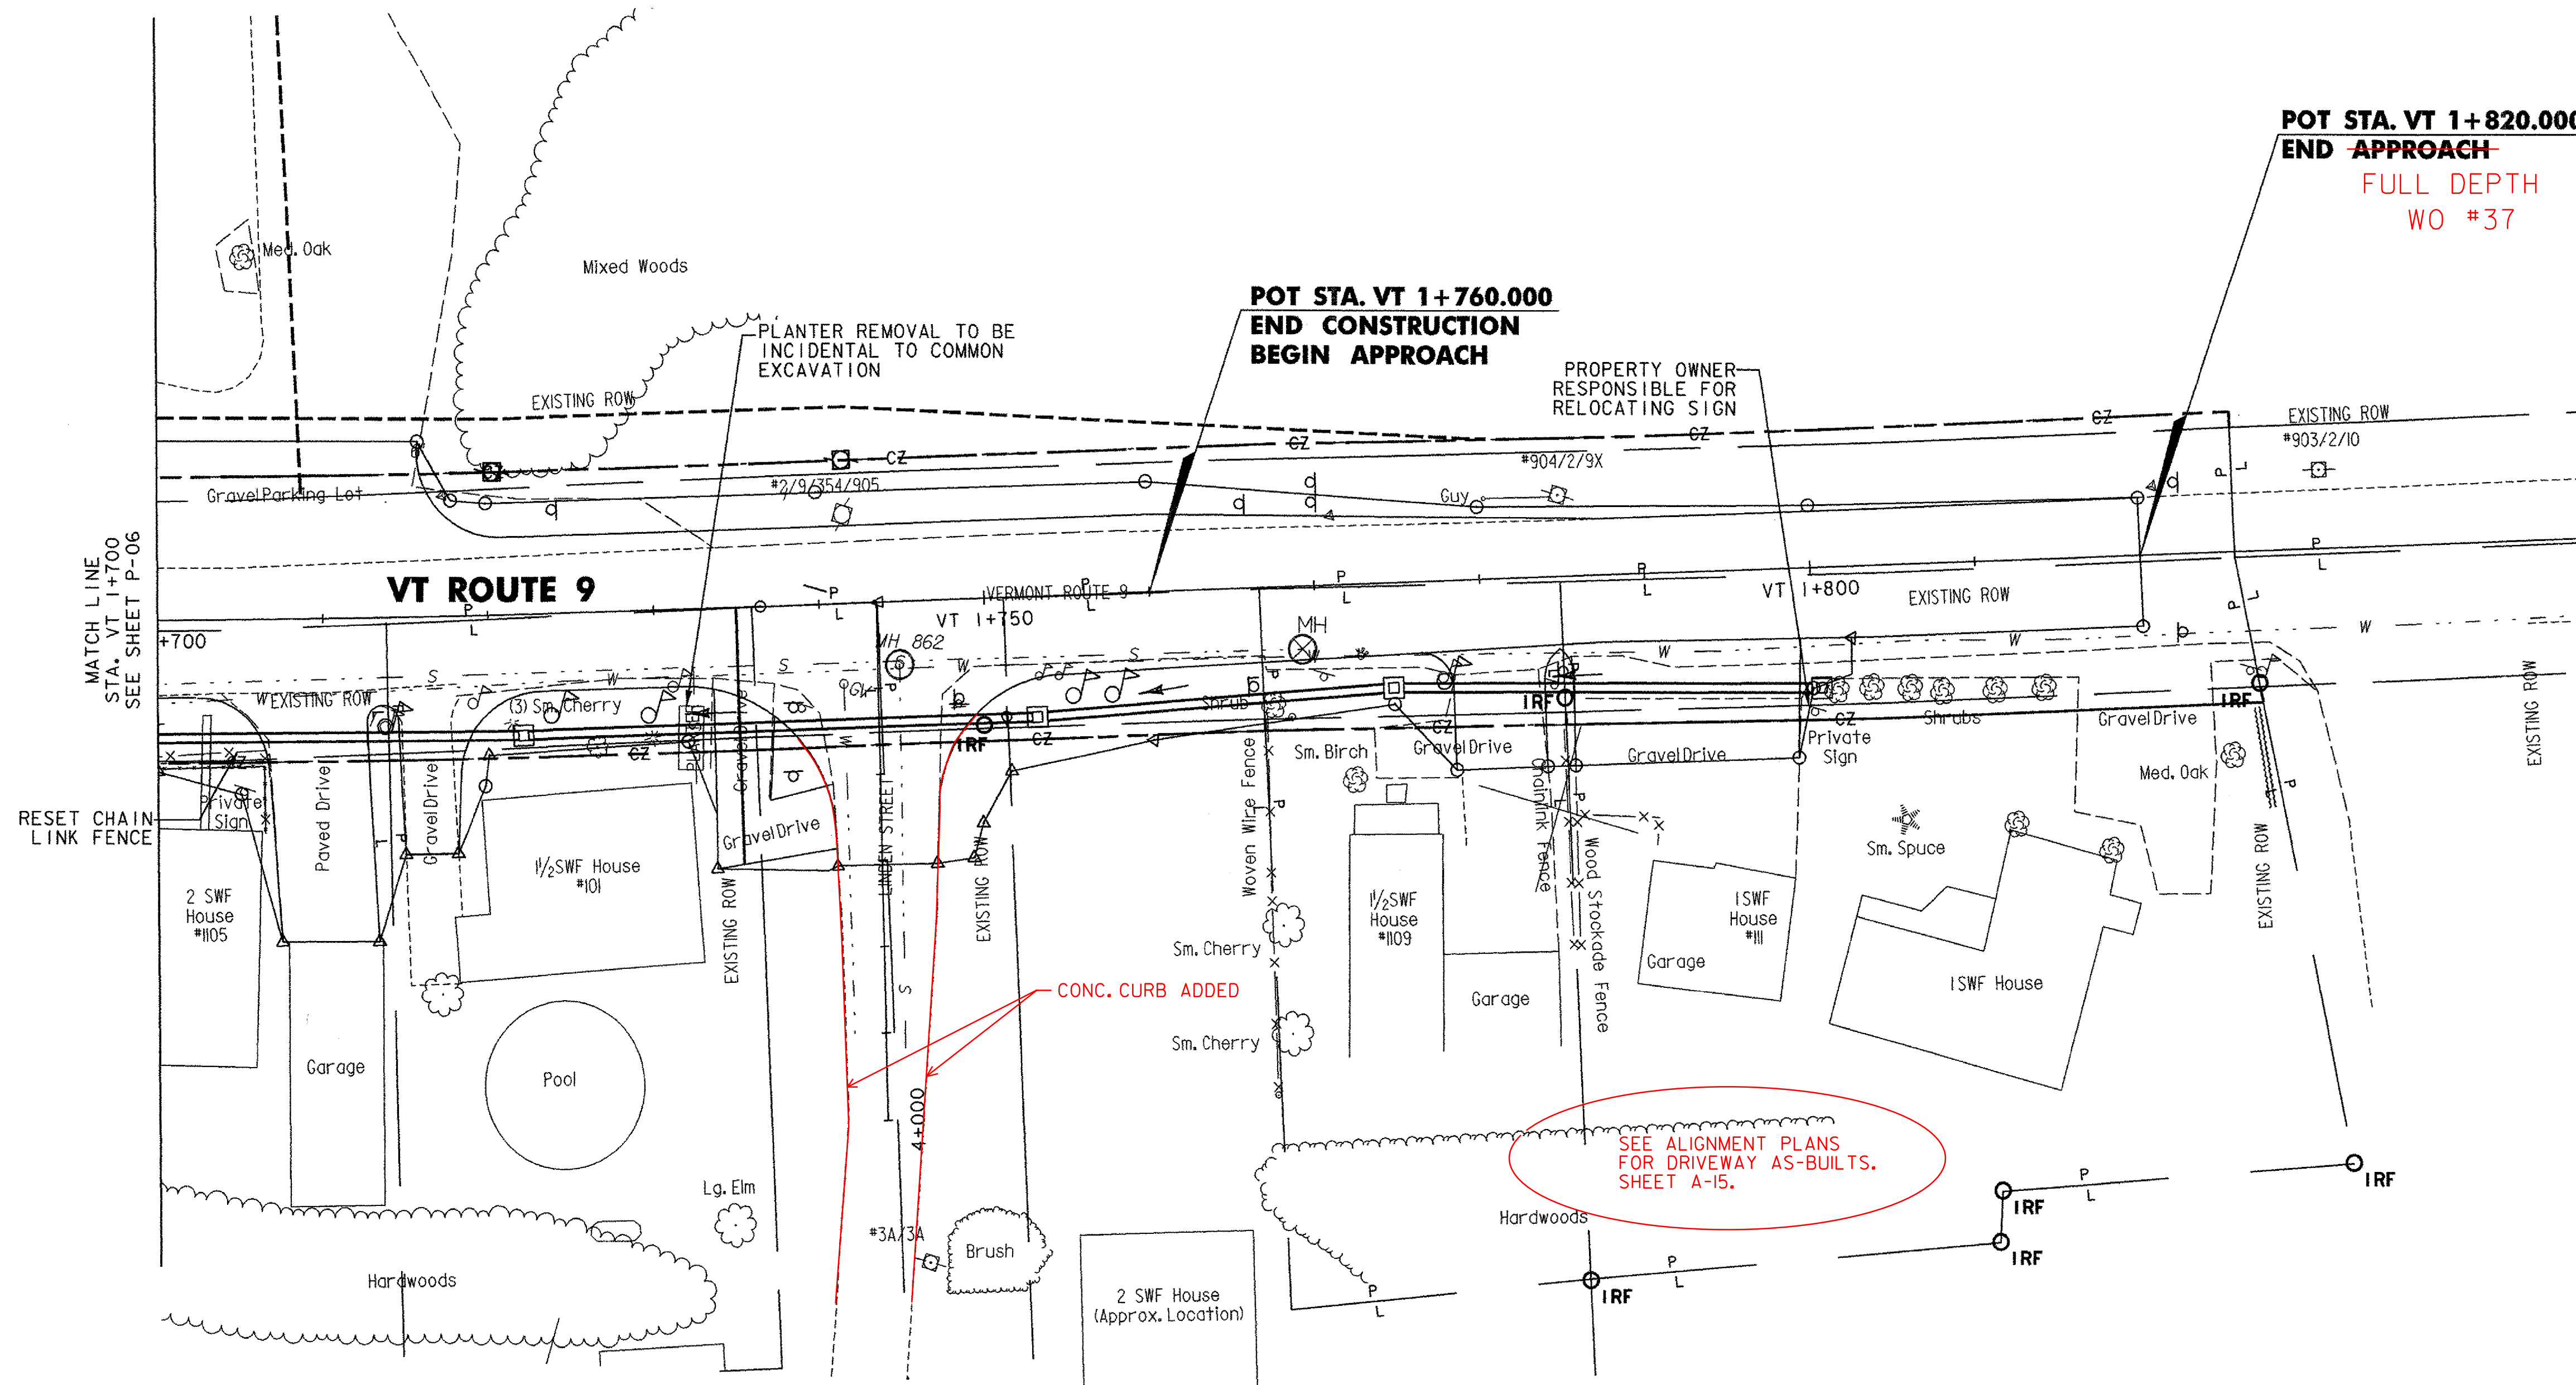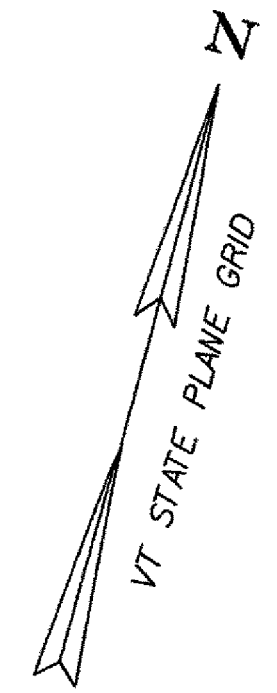

POT STA. VT 1+820.000
END APPROACH
FULL DEPTH
WO #37

POT STA. VT 1+760.000
END CONSTRUCTION
BEGIN APPROACH



PROPERTY OWNER
RESPONSIBLE FOR
RELOCATING SIGN

PLANTER REMOVAL TO BE
INCIDENTAL TO COMMON
EXCAVATION

MATCH LINE
STA. VT 1+700
SEE SHEET P-06

RESET CHAIN
LINK FENCE

SEE ALIGNMENT PLANS
FOR DRIVEWAY AS-BUILTS.
SHEET A-15.

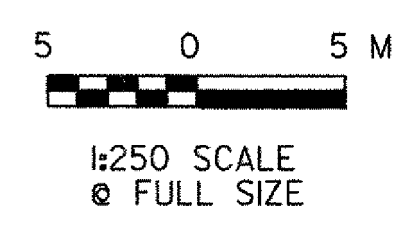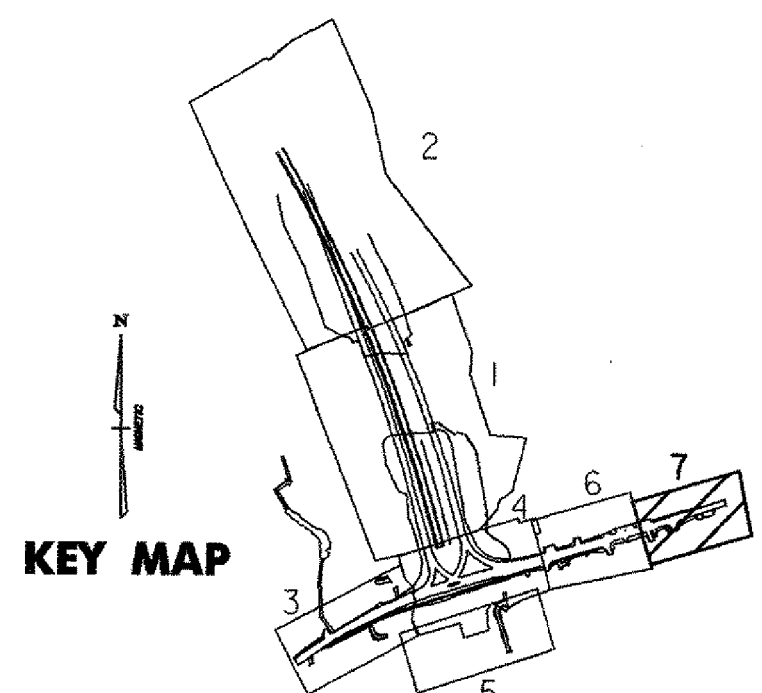

VERMONT AGENCY OF TRANSPORTATION



PROJECT NAME:	BENNINGTON
PROJECT NUMBER:	AC NH 019-1(51)
FILE NAME:	...zd307cigen_plans_250.pxf
DESIGN SUPERVISOR:	GREG EDWARDS
DESIGNED BY:	MARC FOISY
GENERAL PLAN	P-07
PLOT DATE:	1/30/2009
DRAWN BY:	STANTEC
CHECKED BY:	GARY SANTY
SHEET	72 OF 367

vt:\953\active\9530002\transportation\drawing\contract\1\plot_files\zd307cigen_plans_250.pxf