




SEED, WINTER RYE
 STA. VT 1+207.0, LT. - STA. VT 1+253.0, LT.
 STA. VT 1+257.5, LT. - STA. VT 1+332.5, LT.
 STA. VT 1+336.0, LT. - STA. VT 1+370.0, LT.
 STA. VT 1+341.0, LT. - STA. VT 1+357.0, LT.
 STA. VT 1+218.0, RT. - STA. VT 1+370.0, RT.
 STA. VT 1+246.5, RT. - STA. VT 1+308.5, RT.
 STA. VT 1+312.0, RT. - STA. VT 1+370.0, RT.
 STA. DRN 60+005.0, @ - STA. DRN 60+045.0, @


HAY MULCH
 STA. VT 1+207.0, LT. - STA. VT 1+253.0, LT.
 STA. VT 1+257.5, LT. - STA. VT 1+332.5, LT.
 STA. VT 1+336.0, LT. - STA. VT 1+370.0, LT.
 STA. VT 1+341.0, LT. - STA. VT 1+357.0, LT.
 STA. VT 1+218.0, RT. - STA. VT 1+370.0, RT.
 STA. VT 1+246.5, RT. - STA. VT 1+308.5, RT.
 STA. VT 1+312.0, RT. - STA. VT 1+370.0, RT.
 STA. DRN 60+005.0, @ - STA. DRN 60+045.0, @

INLET PROTECTION DEVICE, TYPE I (STONE & BLOCK)
 STA. VT 1+312.6, 3.13 RT.
 STA. VT 1+353.6, 3.42 RT.

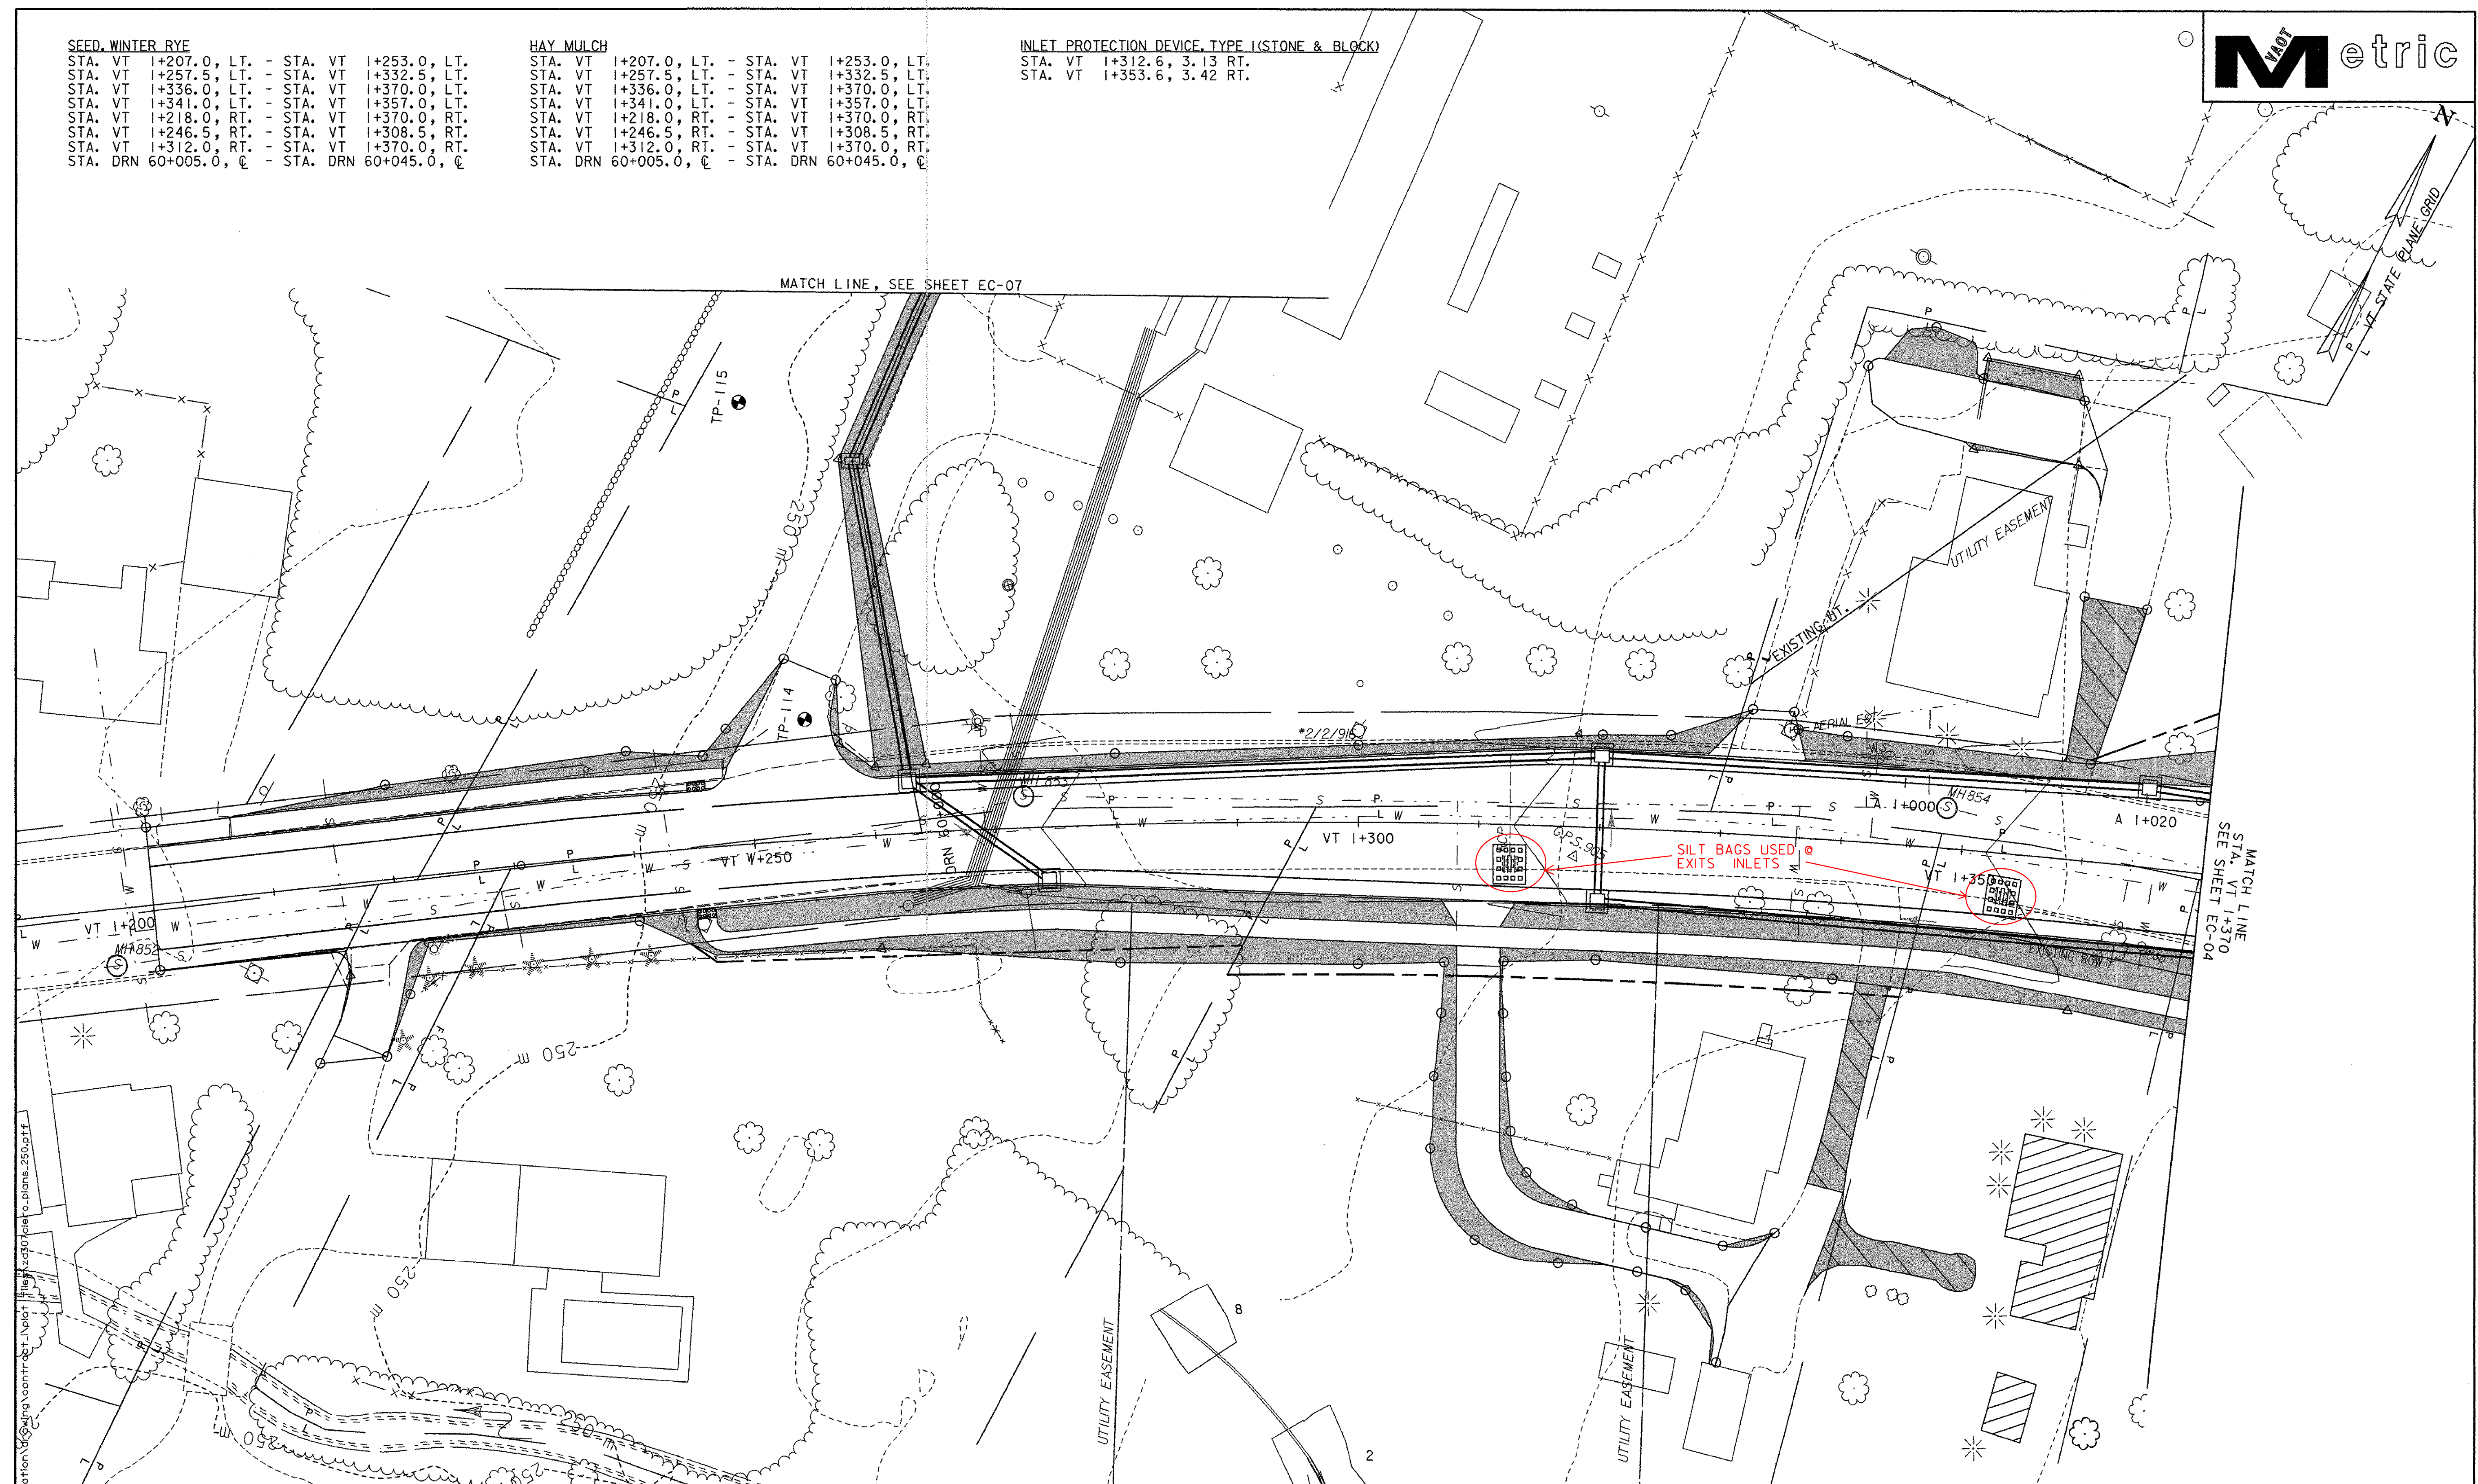

NOTE:
 1. CUT SLOPE LIMITS REPRESENT SLOPE ROUNDING. PROPOSED CONTOURS SHOWN DO NOT INCLUDE CUT SLOPE ROUNDING.
 2. SEED, WINTER RYE IS TO BE USED AS A TEMPORARY MEASURE FOR EPSC ONLY. RURAL OR URBAN CONSERVATION MIXES WILL BE UTILIZED FOR FINAL LANDSCAPING APPLICATIONS. SEE TYPICAL SECTION TS-05 FOR APPLICATION RATES.

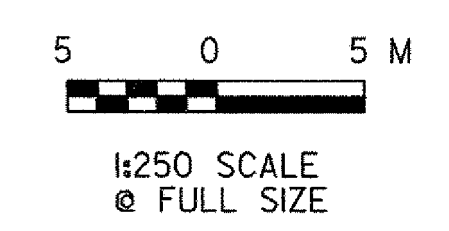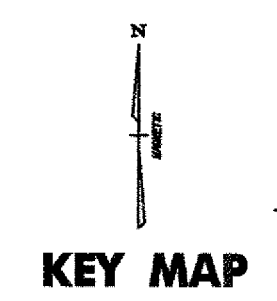

VERMONT AGENCY OF TRANSPORTATION	
	
PROJECT NAME: BENNINGTON	PROJECT NUMBER: AC NH 019-(151)
FILE NAME: ...z307clero_plans_250.ppt	PLOT DATE: 1/30/2009
DESIGN SUPERVISOR: GREG EDWARDS	CHECKED BY: STANTEC
DESIGNED BY: MARC FOISY	DRAWN BY: GARY SANTY
EROSION CONTROL PLAN EC-03	SHEET 92 OF 367