




GEOTEXTILE FOR SILT FENCE
 STA. NB 7+084.8, 48.6m LT. - STA. NB 7+119.9, 48.7m LT.
 STA. NB 7+096.3, 59.3m LT. - STA. NB 7+128.0, 45.0m LT.
 STA. NB 7+119.3, 40.4m LT. - STA. NB 7+134.4, 26.9m LT.
 STA. NB 7+182.2, 41.3m LT. - STA. NB 7+328.8, 53.7m LT.
 STA. NB 7+192.0, 25.5m LT. - STA. NB 7+328.8, 33.0m LT.
 STA. NB 7+186.1, 71.1m LT. - STA. NB 7+320.2, 69.7m LT.

SEED (WINTER RYE)
 STA. NB 7+077.0, LT. - STA. NB 7+127.0, LT.
 STA. NB 7+179.2, LT. - STA. NB 7+334.0, LT.


HAY MULCH
 STA. NB 7+077.0, LT. - STA. NB 7+127.0, LT.
 STA. NB 7+179.2, LT. - STA. NB 7+334.0, LT.

TEMPORARY EROSION MATTING (ON SLOPES)
 STA. NB 7+089.3, LT. - STA. NB 7+136.3, LT.
 STA. NB 7+180.0, LT. - STA. NB 7+339.2, LT.

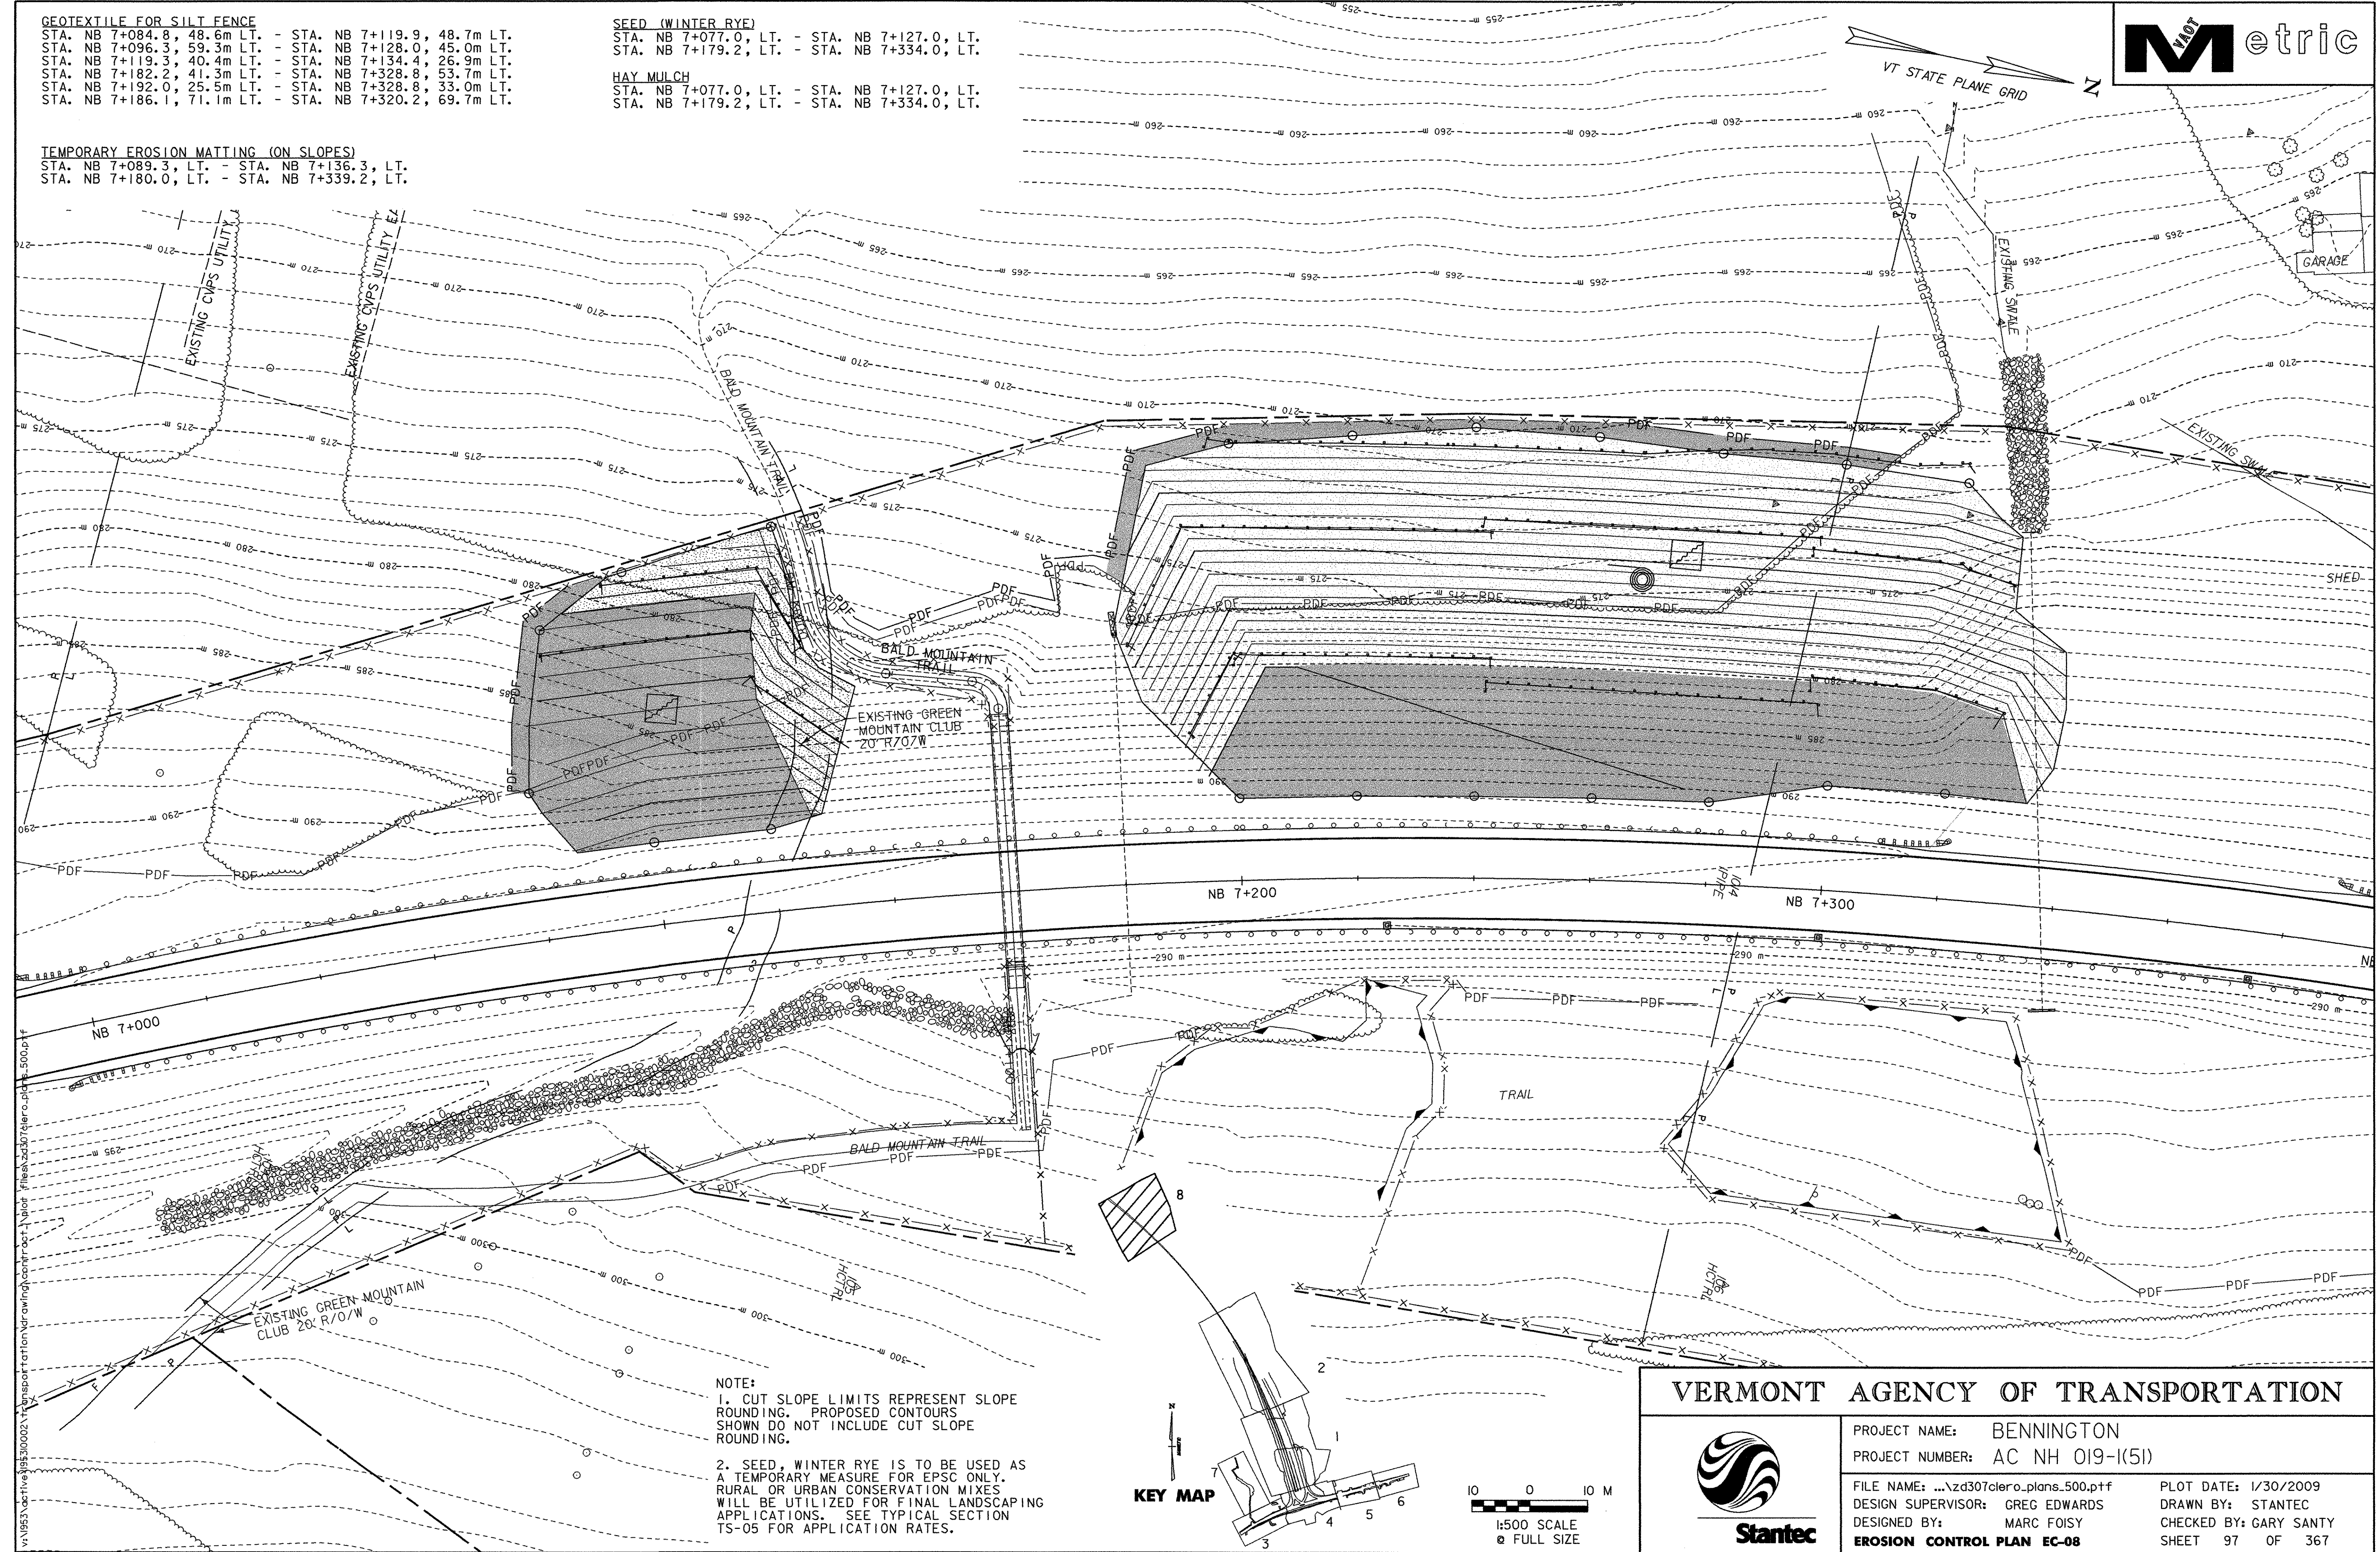

NOTE:
 1. CUT SLOPE LIMITS REPRESENT SLOPE ROUNDING. PROPOSED CONTOURS SHOWN DO NOT INCLUDE CUT SLOPE ROUNDING.
 2. SEED, WINTER RYE IS TO BE USED AS A TEMPORARY MEASURE FOR EPSC ONLY. RURAL OR URBAN CONSERVATION MIXES WILL BE UTILIZED FOR FINAL LANDSCAPING APPLICATIONS. SEE TYPICAL SECTION TS-05 FOR APPLICATION RATES.

KEY MAP

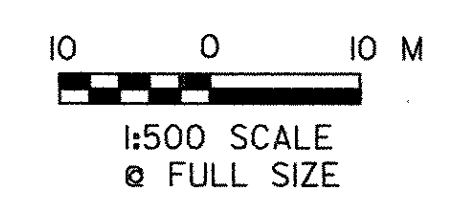

VERMONT AGENCY OF TRANSPORTATION



PROJECT NAME: BENNINGTON	PLOT DATE: 1/30/2009
PROJECT NUMBER: AC NH 019-1(51)	DRAWN BY: STANTEC
FILE NAME: ...z307clero_plans.500.ptf	CHECKED BY: GARY SANTY
DESIGN SUPERVISOR: GREG EDWARDS	SHEET 97 OF 367
DESIGNED BY: MARC FOISY	
EROSION CONTROL PLAN EC-08	