



DURABLE 150 WHITE LINE, THERMOPLASTIC
 STA. NB 6+740.0 TO 7+100.0, SOLID LT. & RT.
 STA. NB 6+740.0 TO 7+100.0, DASHED RT.

DURABLE 150 YELLOW LINE, THERMOPLASTIC
 STA. NB 6+740.0 TO 7+100.0, DOUBLE SOLID C



DELINEATORS W/STEEL POSTS
 AS SHOWN-4 (FOR DETAILS, SEE VTrans STD. E-197)

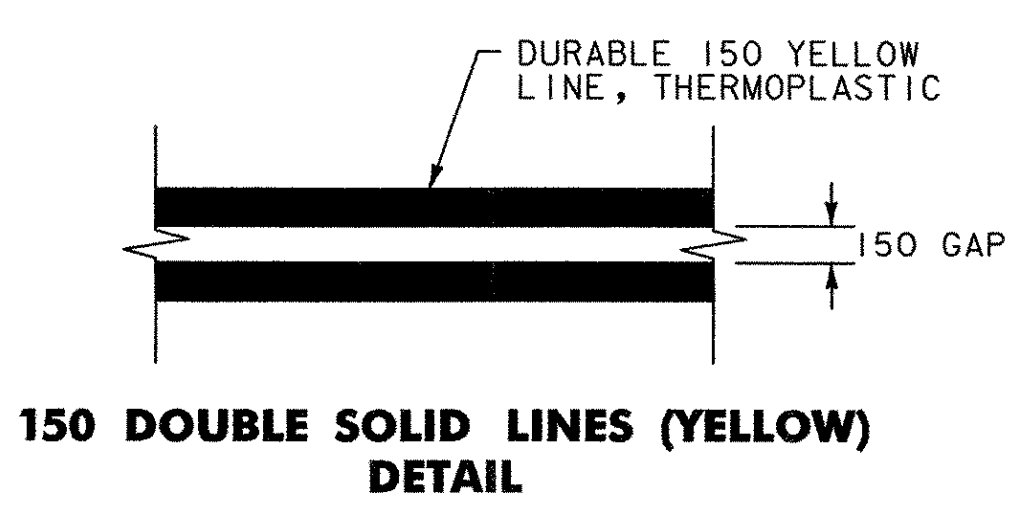

MILLED RUMBLE STRIPS		TYPE
STA. NB 6+740.0 TO NB 6+762.0, LT.		SHOULDER
STA. NB 6+740.0 TO NB 7+100.0, RT.		SHOULDER
STA. NB 6+740.0 TO NB 7+100.0, C		CENTERLINE
STA. NB 6+855.4 TO NB 7+100.0, LT.		SHOULDER

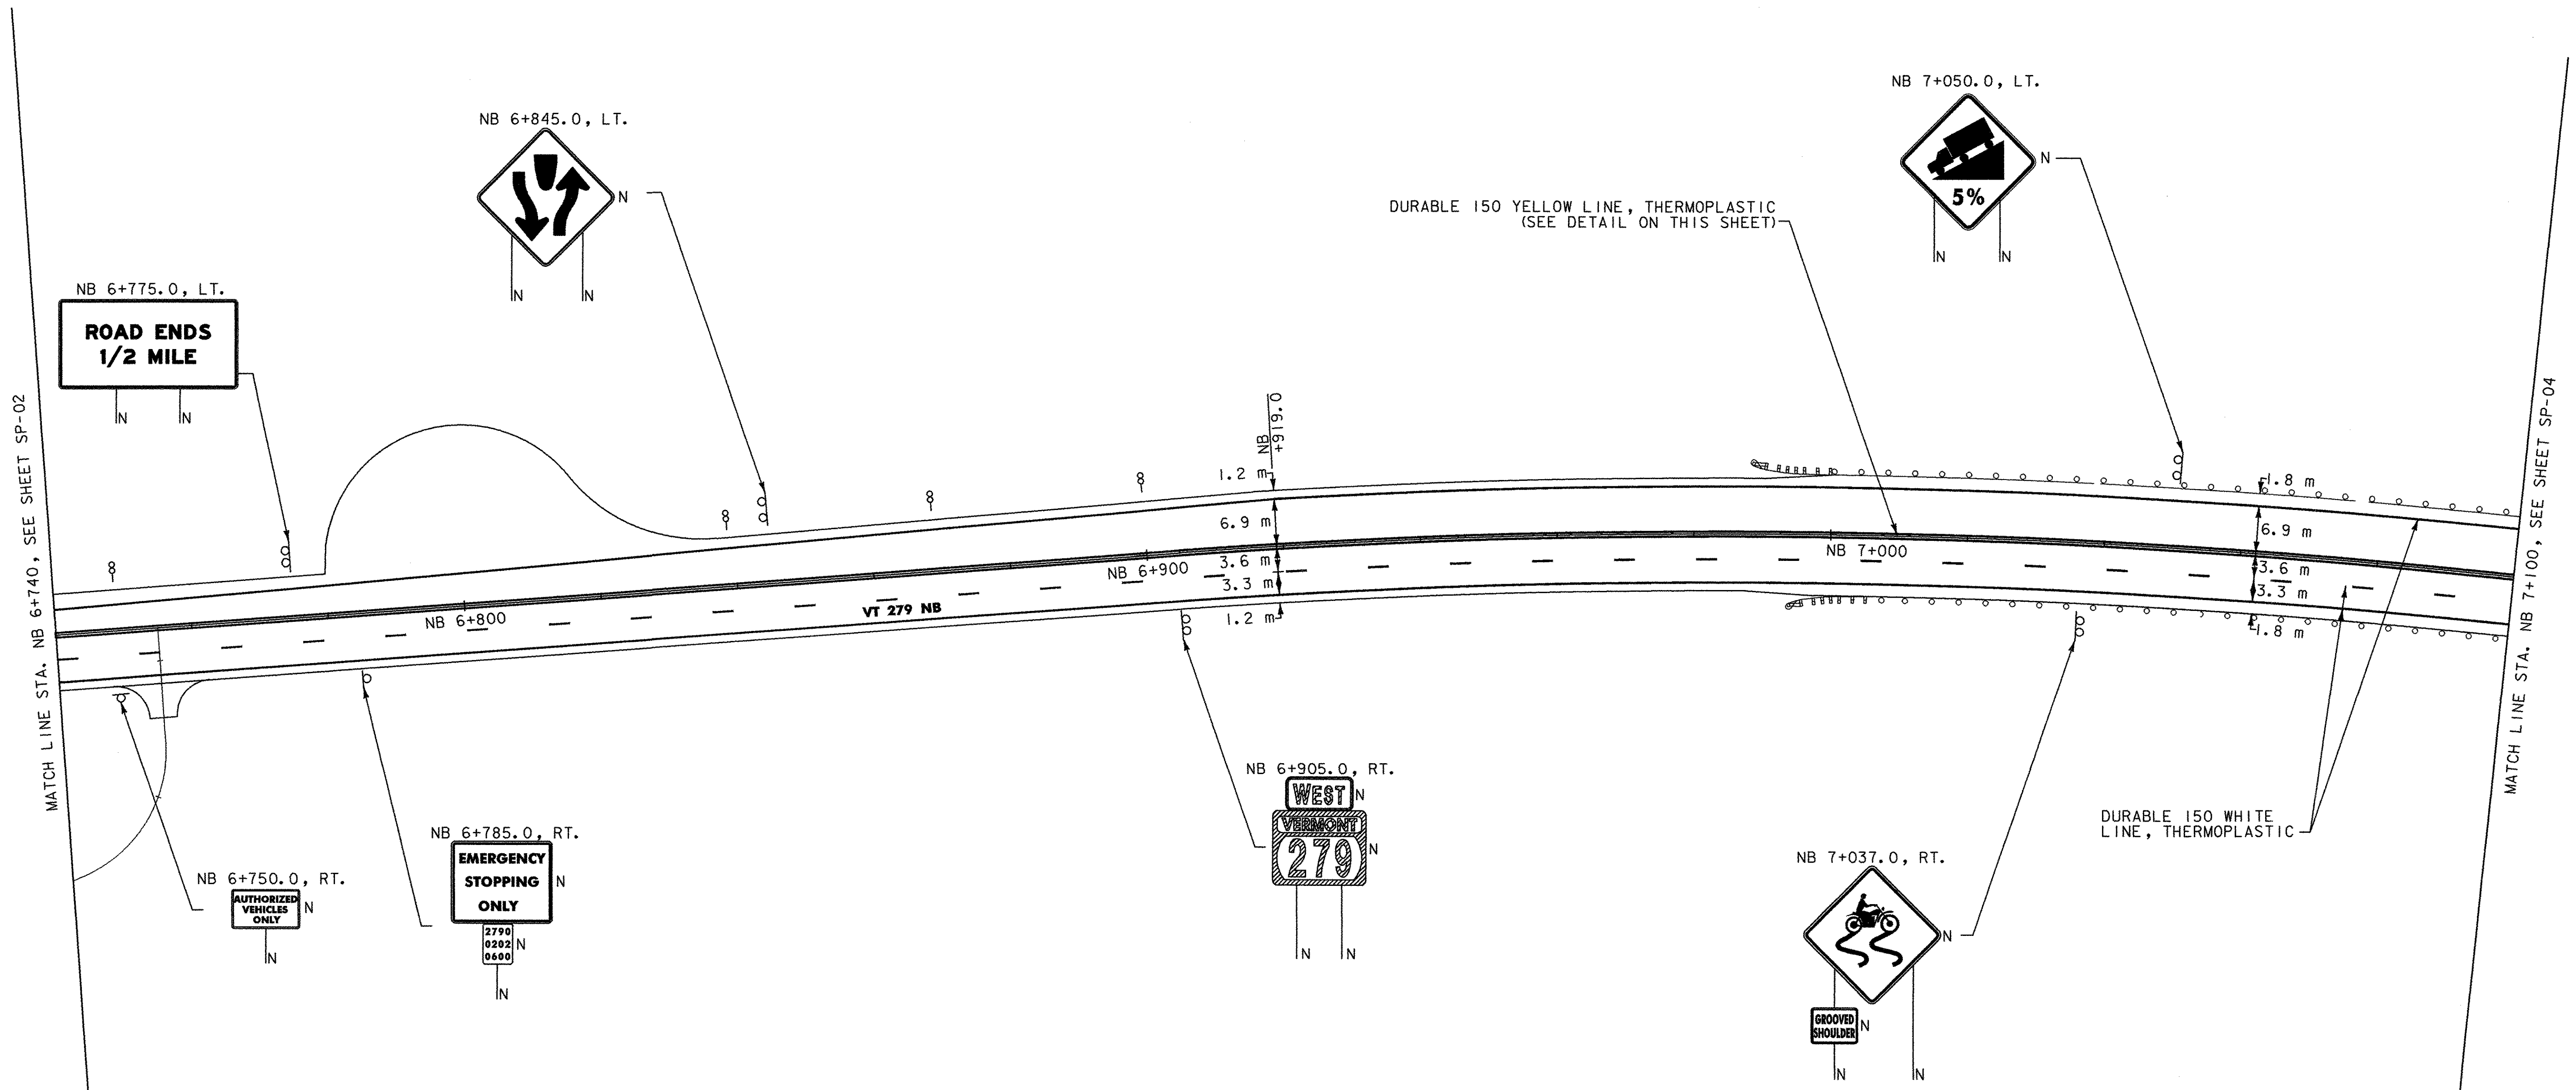

- SIGN & DELINEATOR LEGEND**
- N = NEW
 - R = REMOVE
 - R&S = REMOVE & SALVAGE
 - S = SALVAGE SIGN
 - RET = RETAIN
 - (B-B) = BACK TO BACK
 - ⊙ = RETURN TO TOWN OF BENNINGTON
 - ⊙ = TYPE I (WHITE)
 - ⊙ = TYPE I (AMBER)
 - ⊙ = TYPE I (WHITE W/REF PLAQUE)
 - ⊙ = TYPE II
 - ⊙ = TYPE III (WHITE)
 - ⊙ = TYPE III (AMBER)
 - * = MATCH EXISTING CONDITIONS

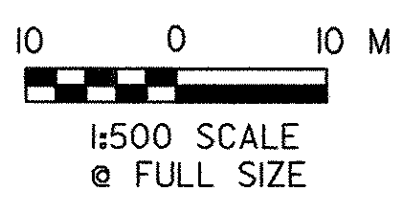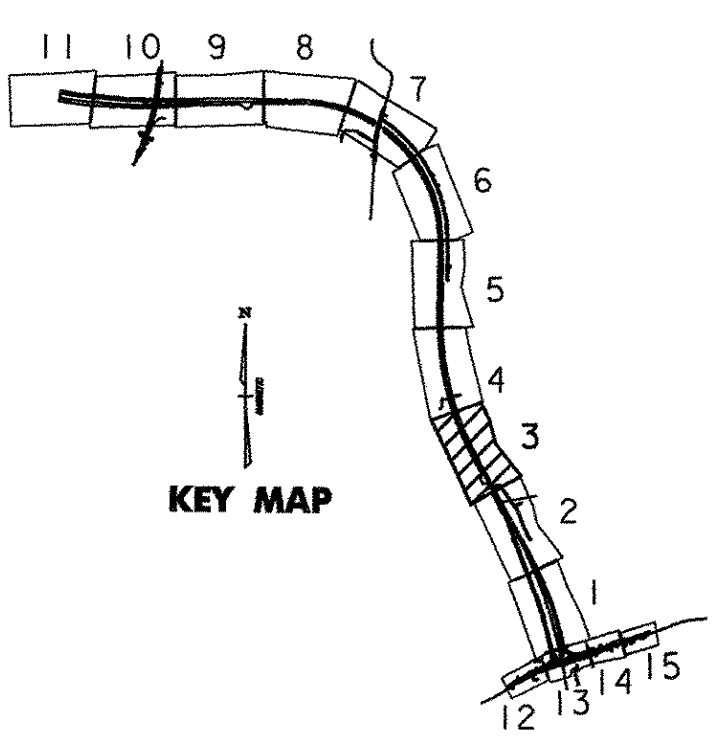

NOTE: ALL DIMENSIONS, NOTES, AND CALLOUTS ARE IN MILLIMETERS (mm) EXCEPT WHERE NOTED

VERMONT AGENCY OF TRANSPORTATION	
	PROJECT NAME: BENNINGTON
	PROJECT NUMBER: AC NH 019-K(51)
FILE NAME: ...\\plot files\zd307\ctxt\sgn.pft	PLOT DATE: 1/30/2009
DESIGN SUPERVISOR: GREG EDWARDS	DRAWN BY: STANTEC
DESIGNED BY: MARC FOISY	CHECKED BY: GARY SANTY
SIGNS AND MARKINGS SP-03	SHEET III OF 367

V:\953\active\9530002\tr\enpsort\action\drawing\contract\plot_files\zd307\ctxt\sgn.pft