








TEMPORARY 100 WHITE LINE &  
DURABLE 100 WHITE LINE, THERMOPLASTIC  
STA. VT 1+200.5 TO VT 1+370.0, DOUBLE SOLID LT. & RT.  
STA. VT 1+315.0 TO VT 1+350.0, DOTTED RT.  
STA. VT 1+350.0 TO VT 1+370.0, SOLID RT. (LANE LINE)

TEMPORARY 100 YELLOW LINE  
& DURABLE 100 YELLOW LINE, THERMOPLASTIC  
STA. VT 1+200.5 TO VT 1+275.0, DOUBLE SOLID, C  
STA. VT 1+275.0 TO VT 1+350.0, DOUBLE SOLID, C TO LT.  
STA. VT 1+275.0 TO VT 1+350.0, DOUBLE SOLID, C TO RT. TO LT.  
STA. VT 1+350.0 TO VT 1+370.0, DOUBLE SOLID, LT.



TEMPORARY 200 YELLOW LINE  
& DURABLE 200 YELLOW LINE, THERMOPLASTIC  
STA. VT 1+275.0 TO VT 1+350.0, DIAGONALS

TEMPORARY LETTER OR SYMBOL  
STA. VT 1+363.2, RT. - "  "  
STA. VT 1+362.9, RT. - "  "

DURABLE LETTER OR SYMBOL, THERMOPLASTIC  
STA. VT 1+265.9, RT. - "  " SIGNAL AHEAD  
STA. VT 1+278.0, RT. - "  "  
STA. VT 1+363.2, RT. - "  "  
STA. VT 1+362.9, RT. - "  " ONLY  
STA. VT 1+351.2, RT. - "  "








REMOVING SIGNS  
AS SHOWN-3  
ERECTING SALVAGED SIGNS  
AS SHOWN-1

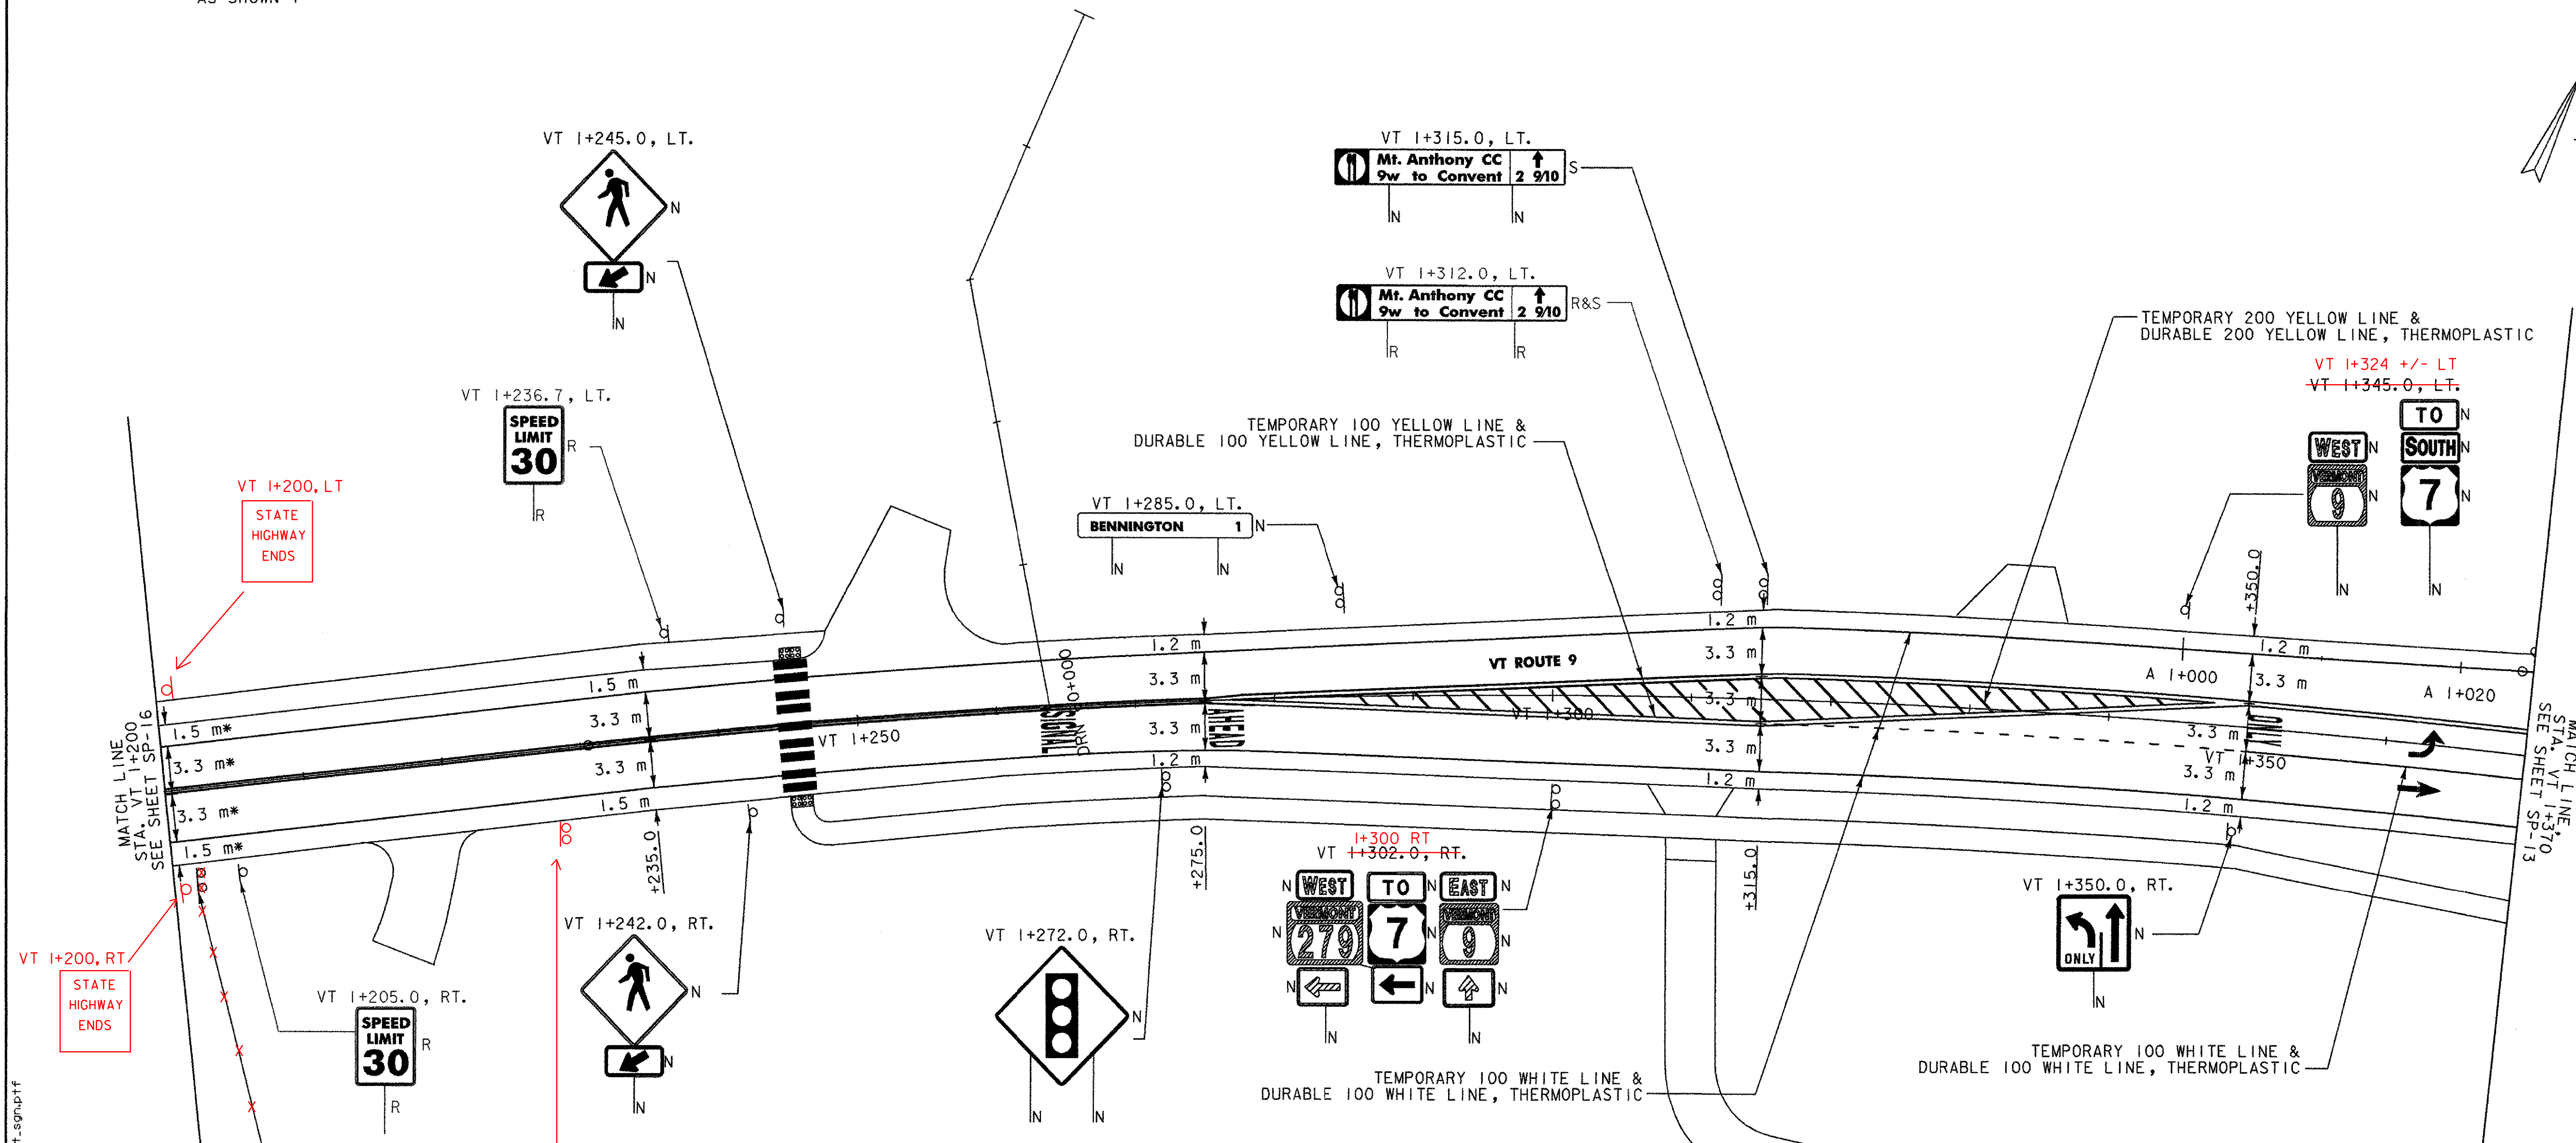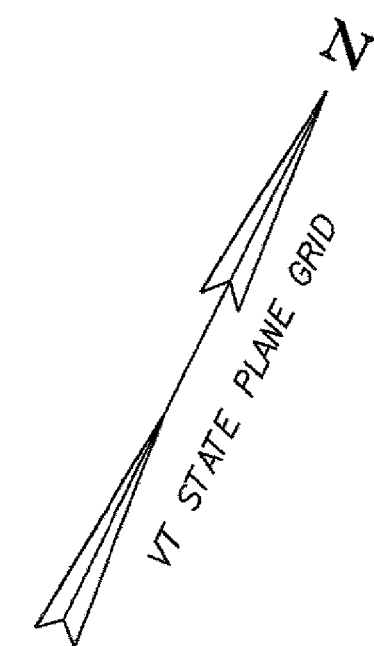

V:\1995\at\1995\0002\Transportation\drawing\contract\1\plot\_files\z307c\xt\_sgn.prf

**SIGN & DELINEATOR LEGEND**

- N = NEW
- R = REMOVE
- R&S = REMOVE & SALVAGE
- S = SALVAGE SIGN
- RET = RETAIN
- B-B = BACK TO BACK
- ⊙ = RETURN TO TOWN OF BENNINGTON
- ↑ = TYPE I (WHITE)
- ↑ = TYPE I (AMBER)
- ↑ = TYPE I (WHITE W/REF PLAQUE)
- ⊙ = TYPE II
- ⊙ = TYPE III (WHITE)
- ⊙ = TYPE III (AMBER)
- \* = MATCH EXISTING CONDITIONS

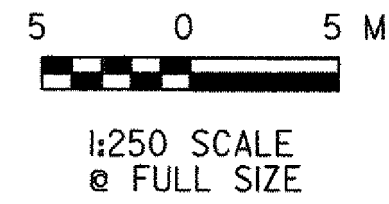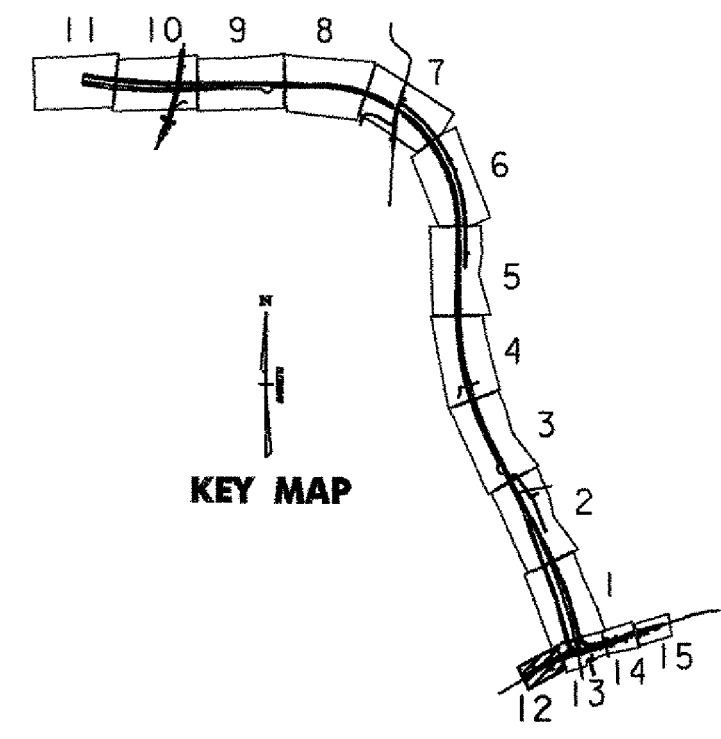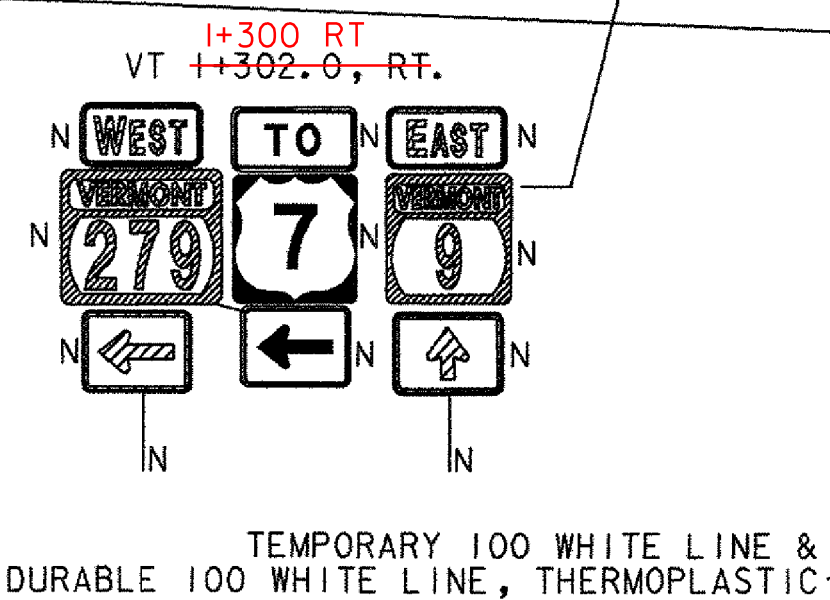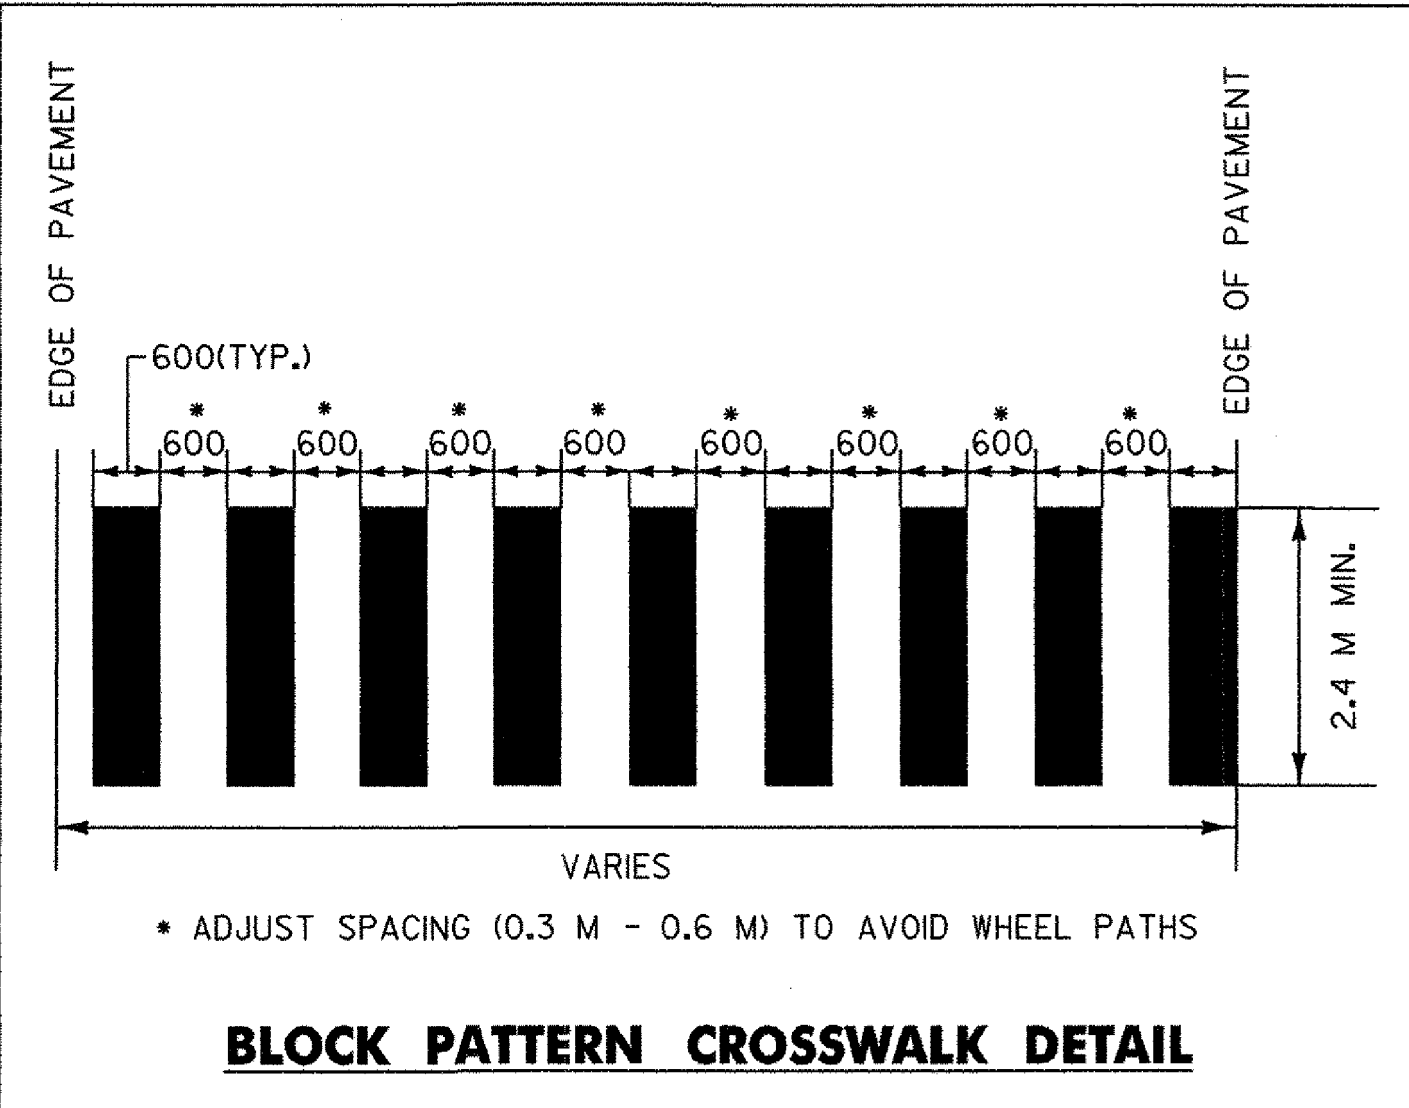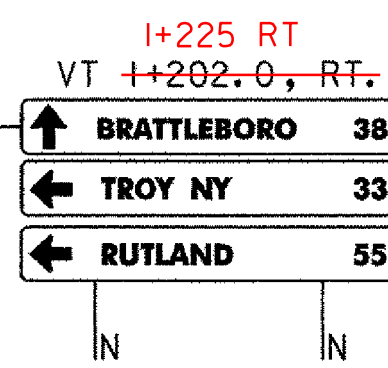

- NOTES:
- 1) FOR ANY TOWN HIGHWAY OR STREET DETAILS, SEE VTRANS STANDARD E-193
  - 2) FOR FURTHER DETAILS ON LIGHTING, SEE LIGHTING PLAN SHEET LP-05
  - 3) ALL DIMENSIONS, NOTES, AND CALLOUTS ARE IN MILLIMETERS (mm) EXCEPT WHERE NOTED

**VERMONT AGENCY OF TRANSPORTATION**



PROJECT NAME: BENNINGTON  
PROJECT NUMBER: AC NH 019-(K5)  
FILE NAME: ...:\plot\_files\z307c\xt\_sgn.prf PLOT DATE: 1/30/2009  
DESIGN SUPERVISOR: GREG EDWARDS DRAWN BY: STANTEC  
DESIGNED BY: MARC FOISY CHECKED BY: GARY SANTY  
SIGNS AND MARKINGS SP-12 SHEET 120 OF 367