


REMOVING SIGNS
AS SHOWN-5

ERECTING SALVAGED SIGNS
AS SHOWN-2

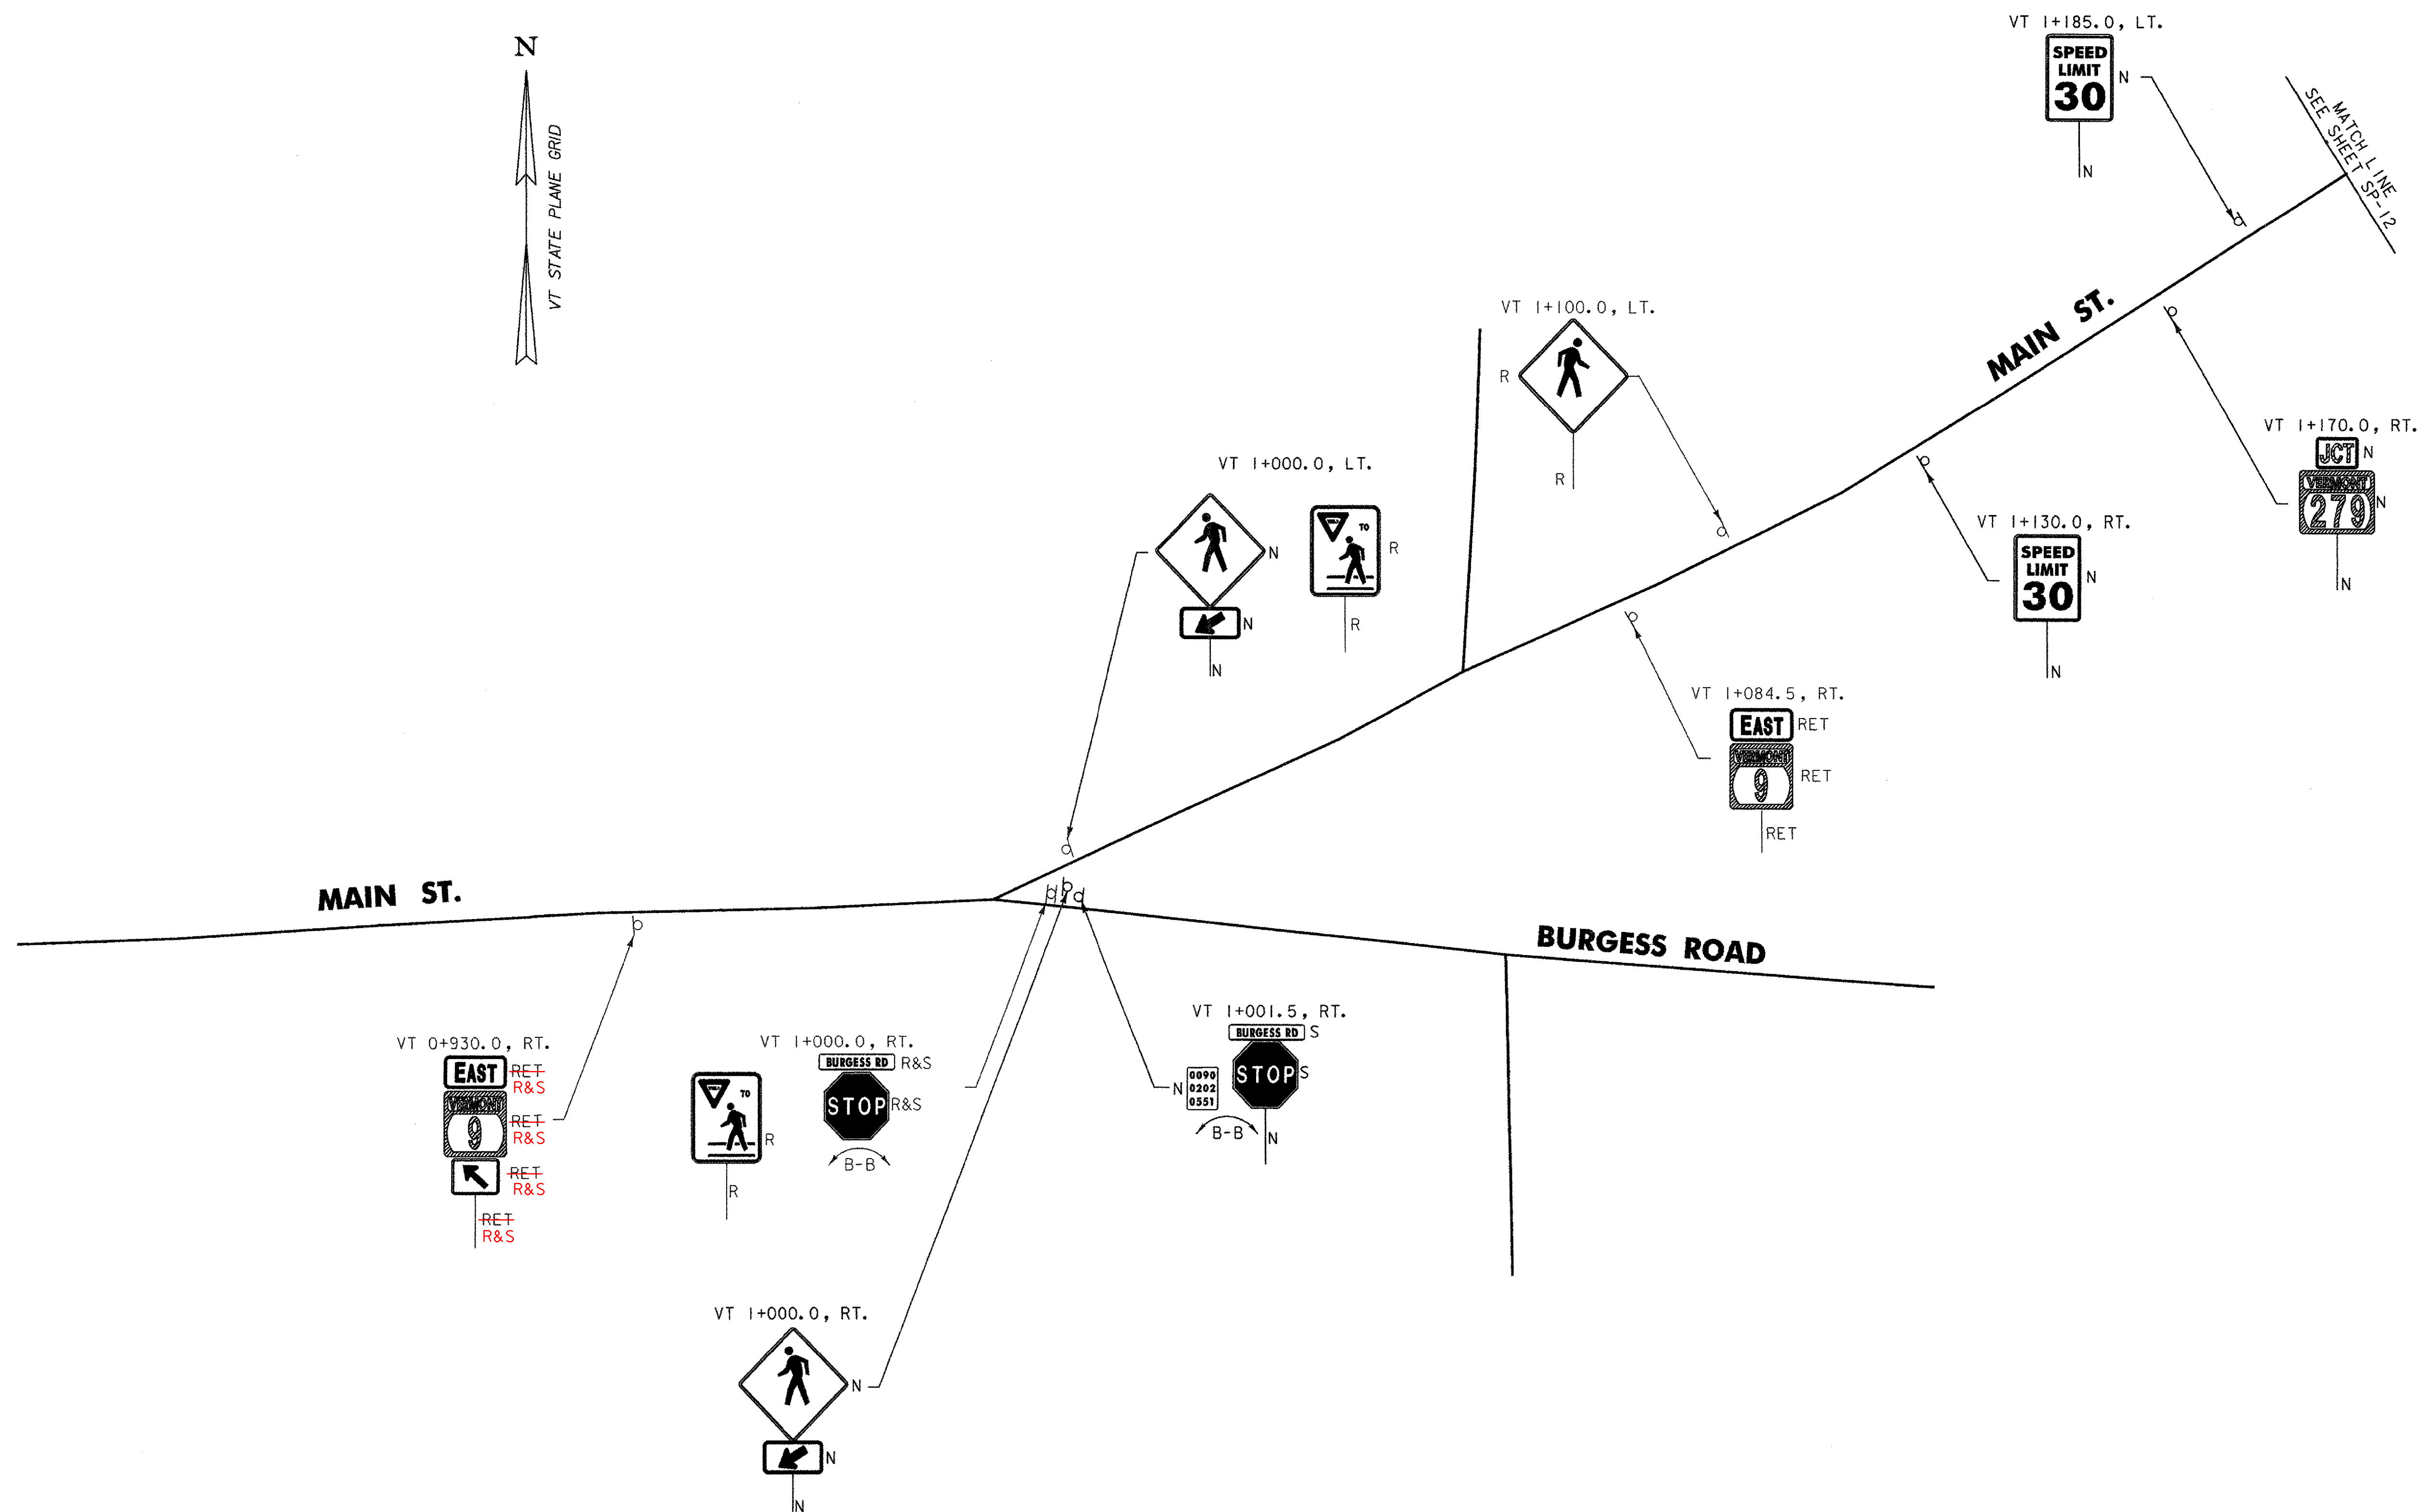

SIGN LEGEND

N	= NEW
R	= REMOVE
R&S	= REMOVE & SALVAGE
S	= SALVAGE SIGN
RET	= RETAIN
(B-B)	= BACK TO BACK
⓪	= RETURN TO TOWN OF BENNINGTON

VERMONT AGENCY OF TRANSPORTATION



Stantec

PROJECT NAME: BENNINGTON
PROJECT NUMBER: AC NH 019-(K51)

FILE NAME: ...\\plot files\zd307citxt.sgn.ptf PLOT DATE: 1/30/2009
DESIGN SUPERVISOR: GREG EDWARDS DRAWN BY: STANTEC
DESIGNED BY: MARC FOISY CHECKED BY: GARY SANTY
SIGNS AND MARKINGS SP-16 SHEET 125 OF 367

V:\953\active\9530002\transportation\drawing\contract\plot_files\zd307citxt.sgn.ptf