



VT 1+431

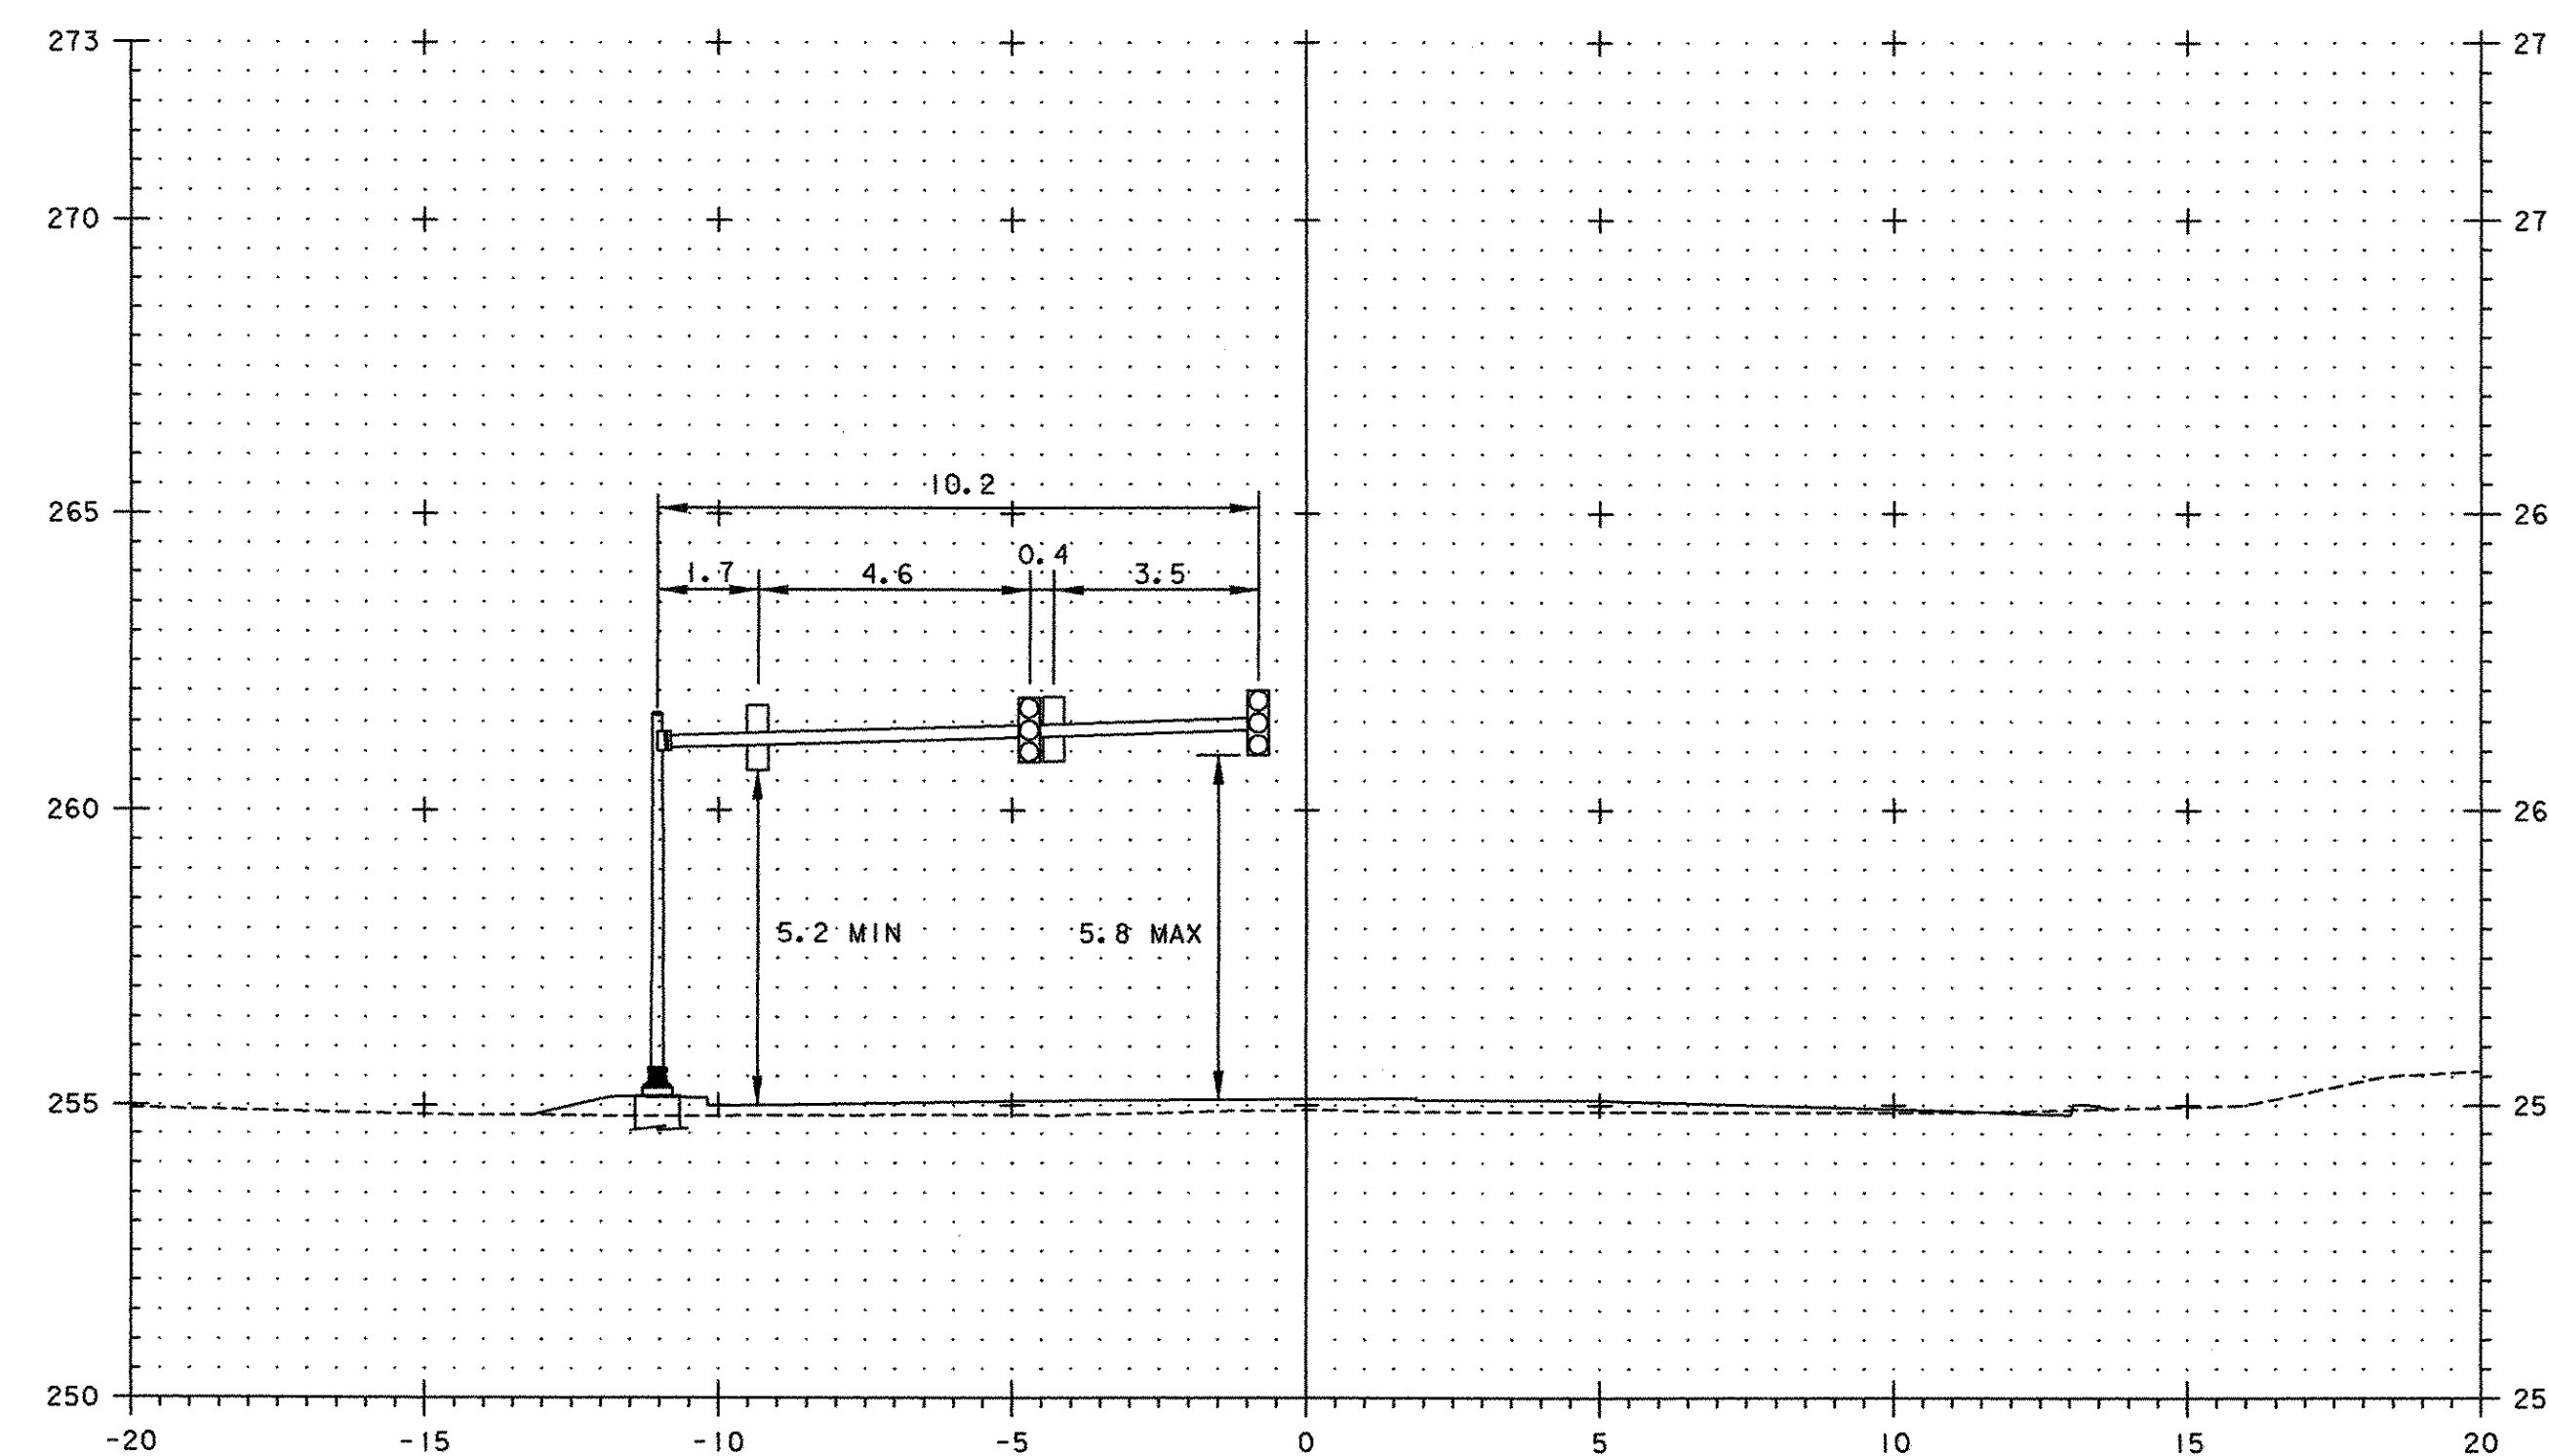

VT 1+442.160
SKEWED 128.32°

MAST ARM DETAILS

V:\953\active\9530002\transportation\drawing\contract\plot_files\zd307tsnd.dpf

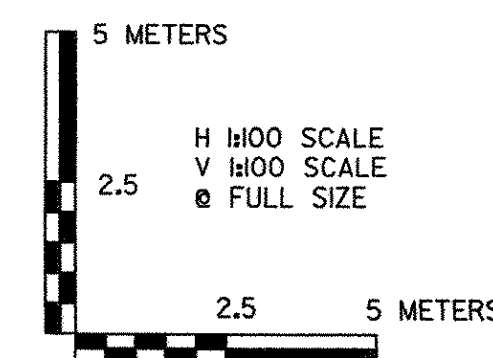

VERMONT AGENCY OF TRANSPORTATION



PROJECT NAME: BENNINGTON
PROJECT NUMBER: AC NH 019-1(51)

FILE NAME: ...\plot_files\zd307c\tsnd.prf PLOT DATE: 1/29/2009
DESIGN SUPERVISOR: GREG EDWARDS DRAWN BY: STANTEC
DESIGNED BY: MARC FOISY CHECKED BY: GARY SANTY
TRAFFIC SIGNAL NOTES & DETAILS TSND-04 SHEET 146 OF 367