


POT STA. VT 1+200.000  
BEGIN APPROACH

POC STA. VT 1+260.000  
END APPROACH  
BEGIN CONSTRUCTION

PROPOSED UNDERGROUND  
UTILITY DUCT, BANKS  
SEE SHEET U-05


#3  
45' CI3  
12 AI-3T RISER  
7.8 m @ NEW ROAD  
PROPOSED 20 COPPER WATER SERVICE  
WITH CORPORATION AND CURB STOP  
W/BOX. TYPICAL UNLESS NOTED  
OTHERWISE. SEE DETAIL ON SHEET U-06

#4  
45' CI3  
12 AGA-3T RISER  
1.5 m @ NEW ROAD

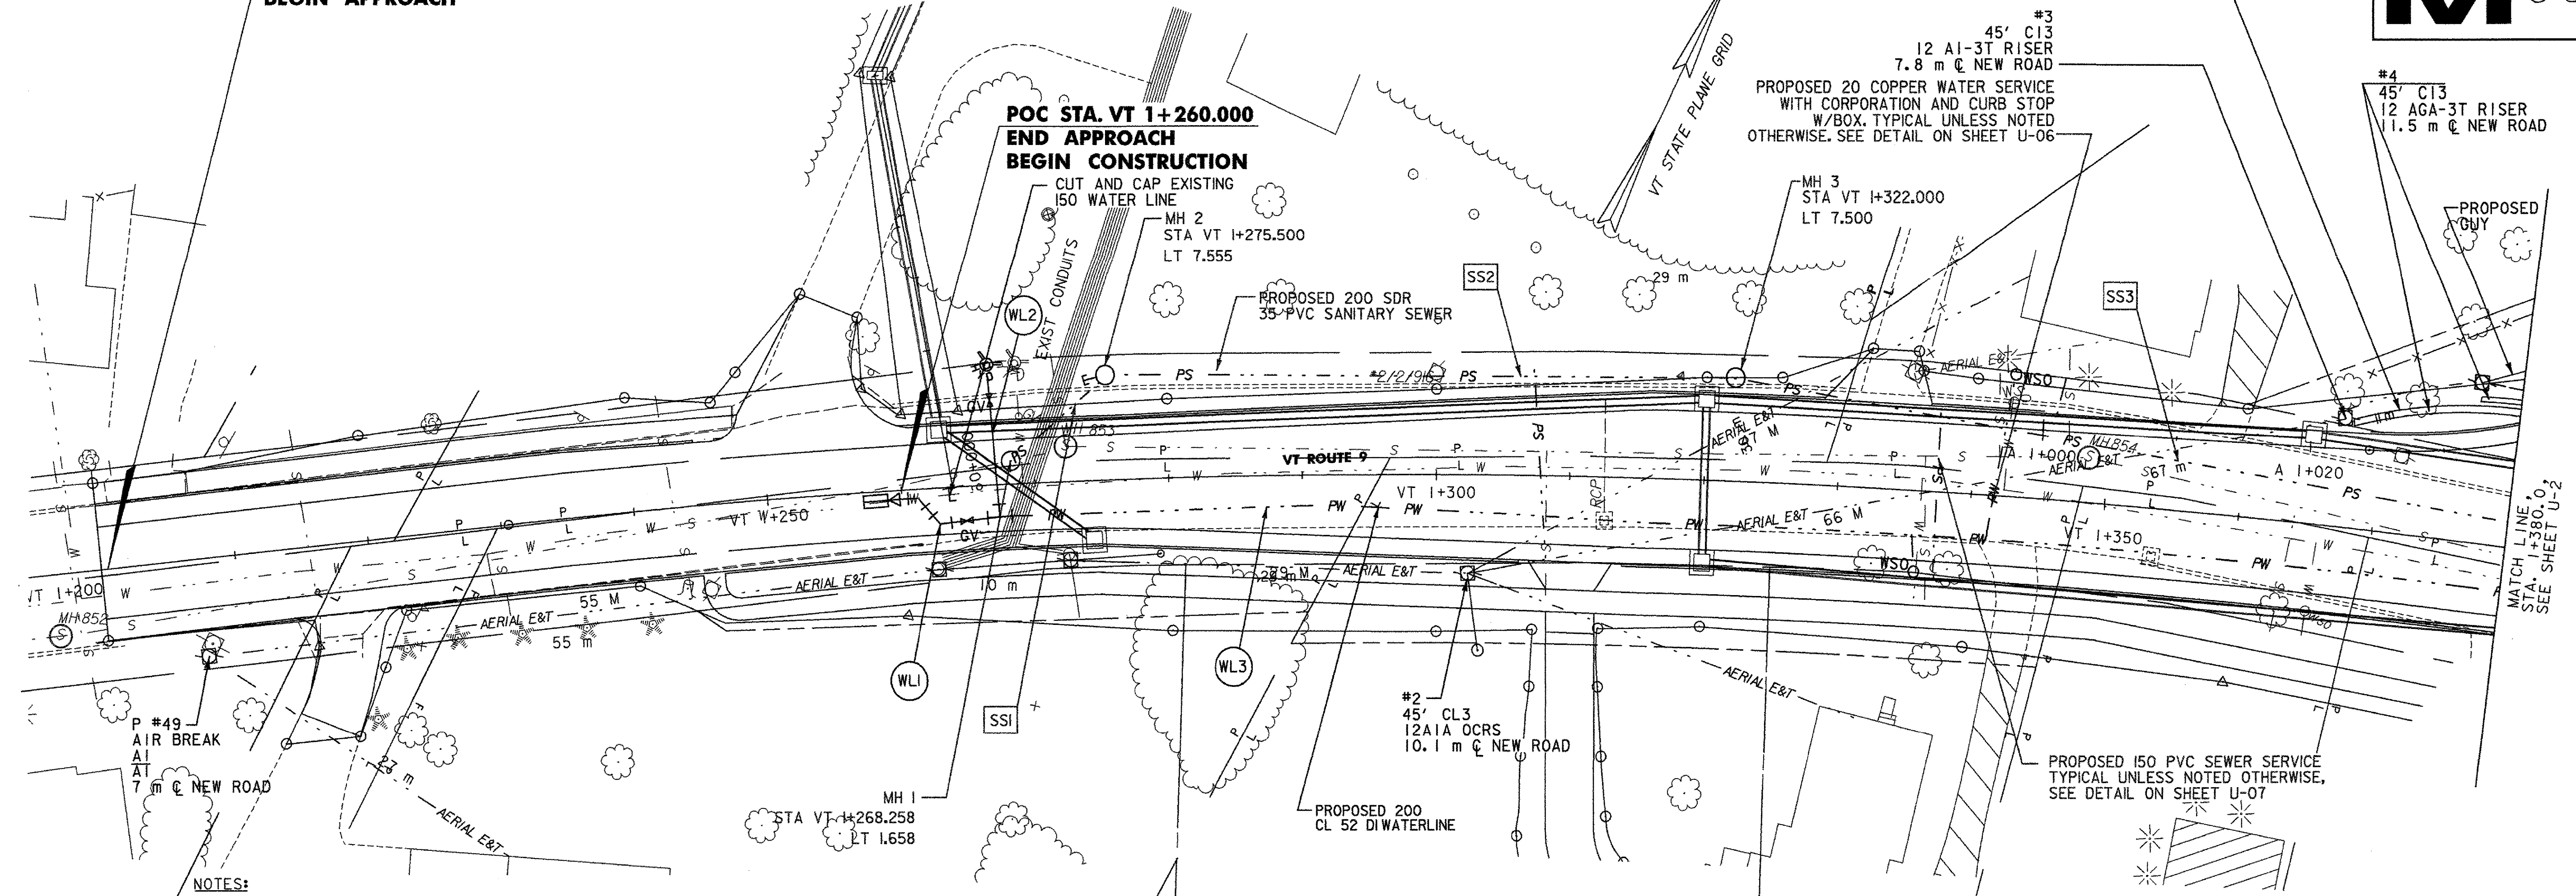

NOTES:

1. UNDERGROUND CONDUITS SHALL BE INSTALLED WITHIN 90 DAYS OF CONTRACT AWARD (SEE SPECIAL PROVISIONS) ONCE CONDUITS ARE INSTALLED, UTILITIES WILL NEED APPROXIMATELY 3 MONTHS TO COMPLETE THEIR WORK. ALL OTHER WORK IN THE IMMEDIATE VICINITY THAT COULD IMPACT THE UTILITY WORK SHALL STOP UNTIL THE UTILITIES HAVE RELOCATED UNDERGROUND.
2. THE UTILITY COMPANIES SHALL BE NOTIFIED 2 WEEKS IN ADVANCE OF ANY EXCAVATION RELATED TO THE CONDUITS. THEIR INSPECTOR SHALL BE "ON-SITE" PRIOR TO COMMENCEMENT OF WORK.
3. CONDUIT SHALL INCLUDE SWEEP AT POLES. CONDUIT MUST TERMINATE ABOVE GROUND. CONTRACTOR TO BLOW-IN PULL STRINGS IN EACH CONDUIT.
4. REMOVAL OF EXISTING WATER AND SEWER LINES SHALL BE PAID INCIDENTAL TO ITEMS "TRANSFER TO NEW SYSTEM, SANITARY SEWER SYSTEM" AND "TRANSFER TO NEW SYSTEM, WATER SYSTEM."

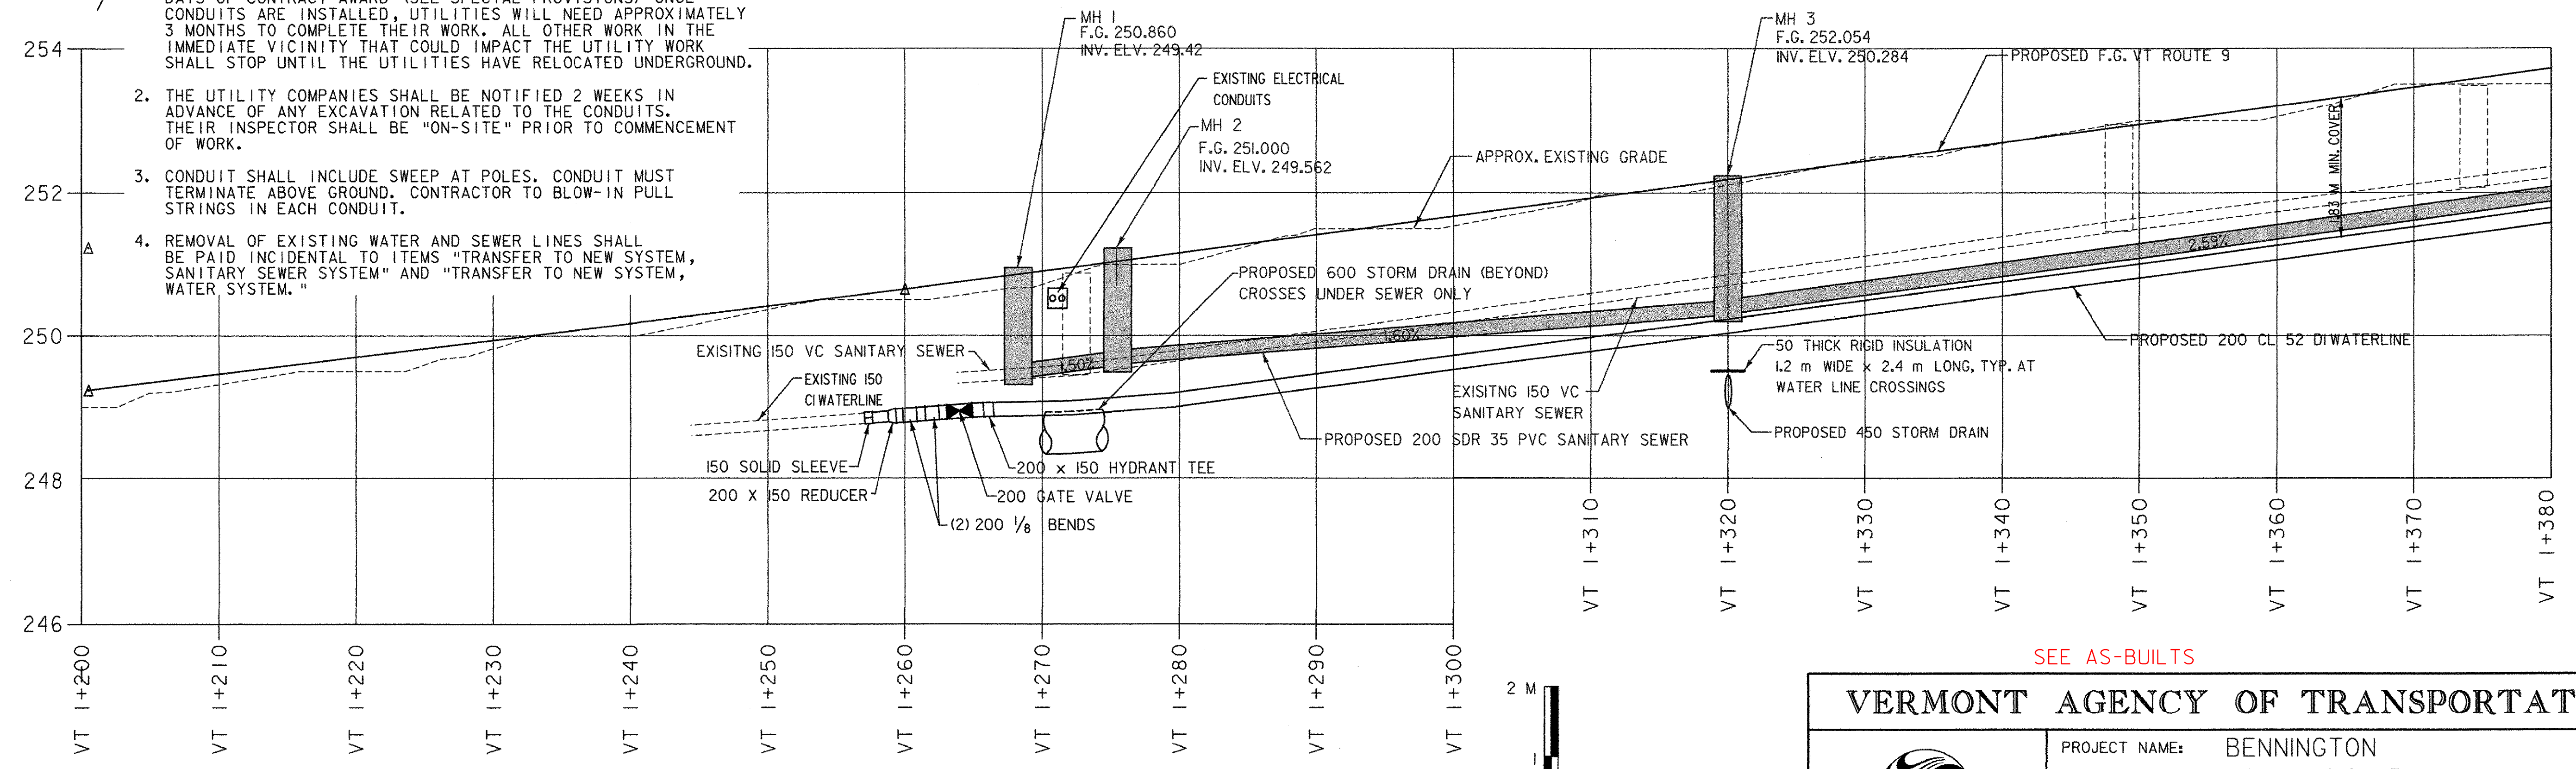


SEE AS-BUILTS

VERMONT AGENCY OF TRANSPORTATION



PROJECT NAME:	BENNINGTON
PROJECT NUMBER:	AC NH 019-(K51)
FILE NAME:	...plot files\vd307clul.pff
DESIGN SUPERVISOR:	GREG EDWARDS
DESIGNED BY:	T. KNIGHT
UTILITY RELOCATION PLAN U-01	
PLOT DATE:	2/27/2009
DRAWN BY:	STANTEC
CHECKED BY:	M. CHENETTE
SHEET	157 OF 367

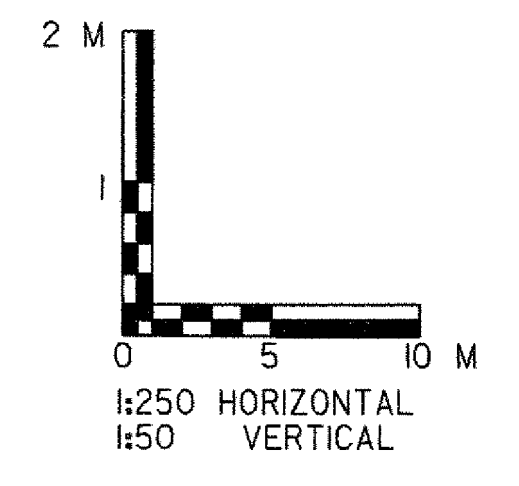

V:\953\active\9530002\transportation\drawing\contract\l\plot\_files\vd307clul.pff