



UTILITY DUCT BANK

(NOT TO SCALE)
 (TO BE PAID FOR AS SPECIAL PROVISION - (DUCT BANK))
 VT ROUTE 9 STA. 1+377 - 1+515
 (UTILITY POLE #3 TO UTILITY POLE #5)

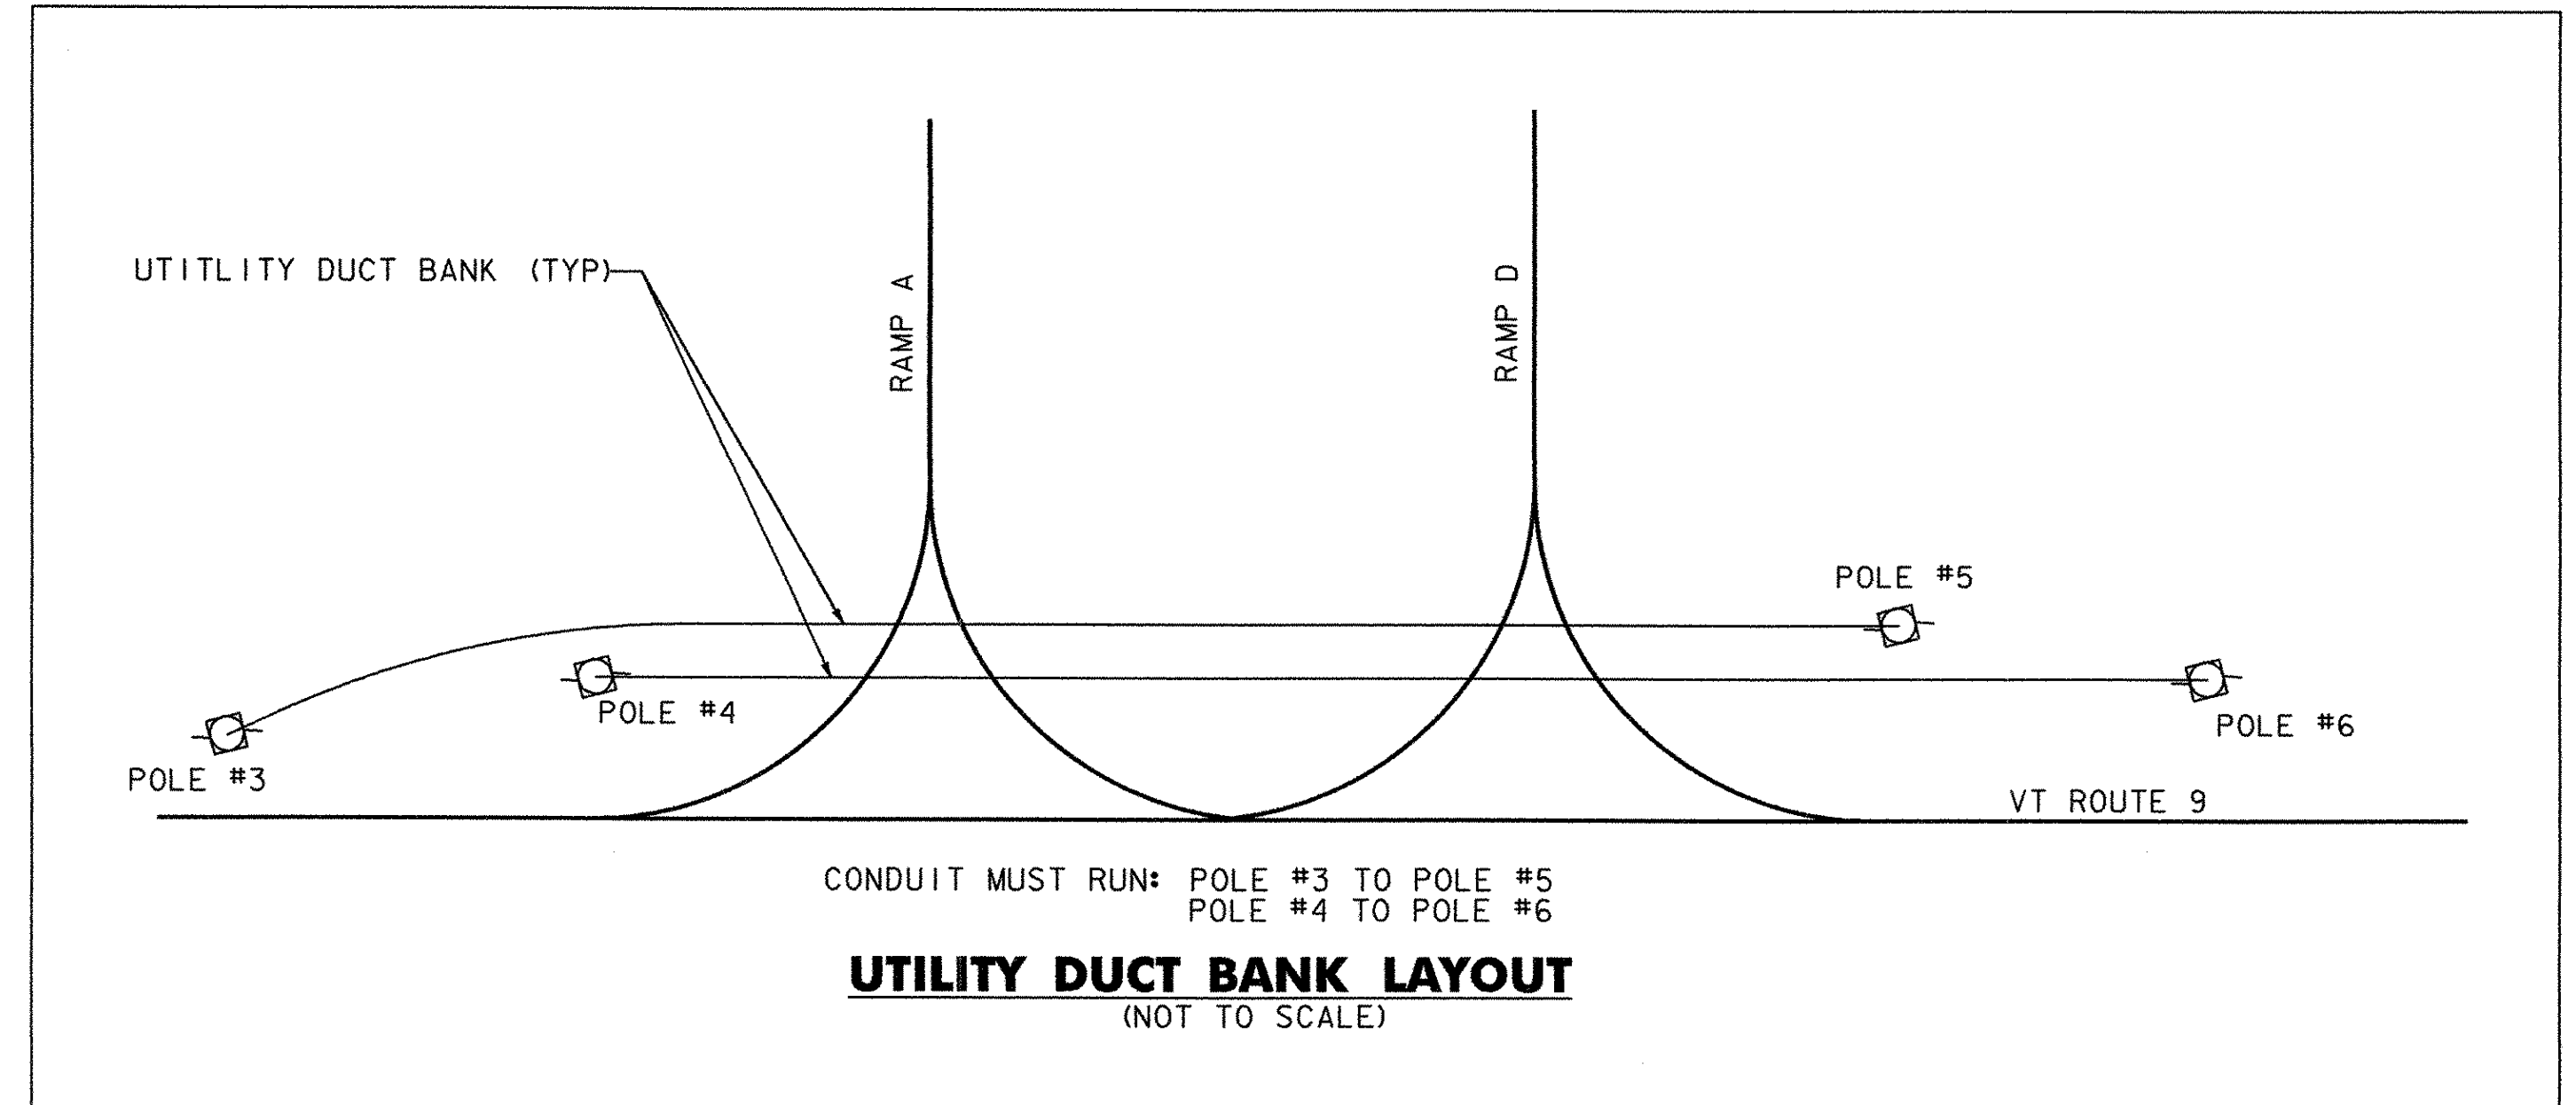


UTILITY DUCT BANK LAYOUT

(NOT TO SCALE)

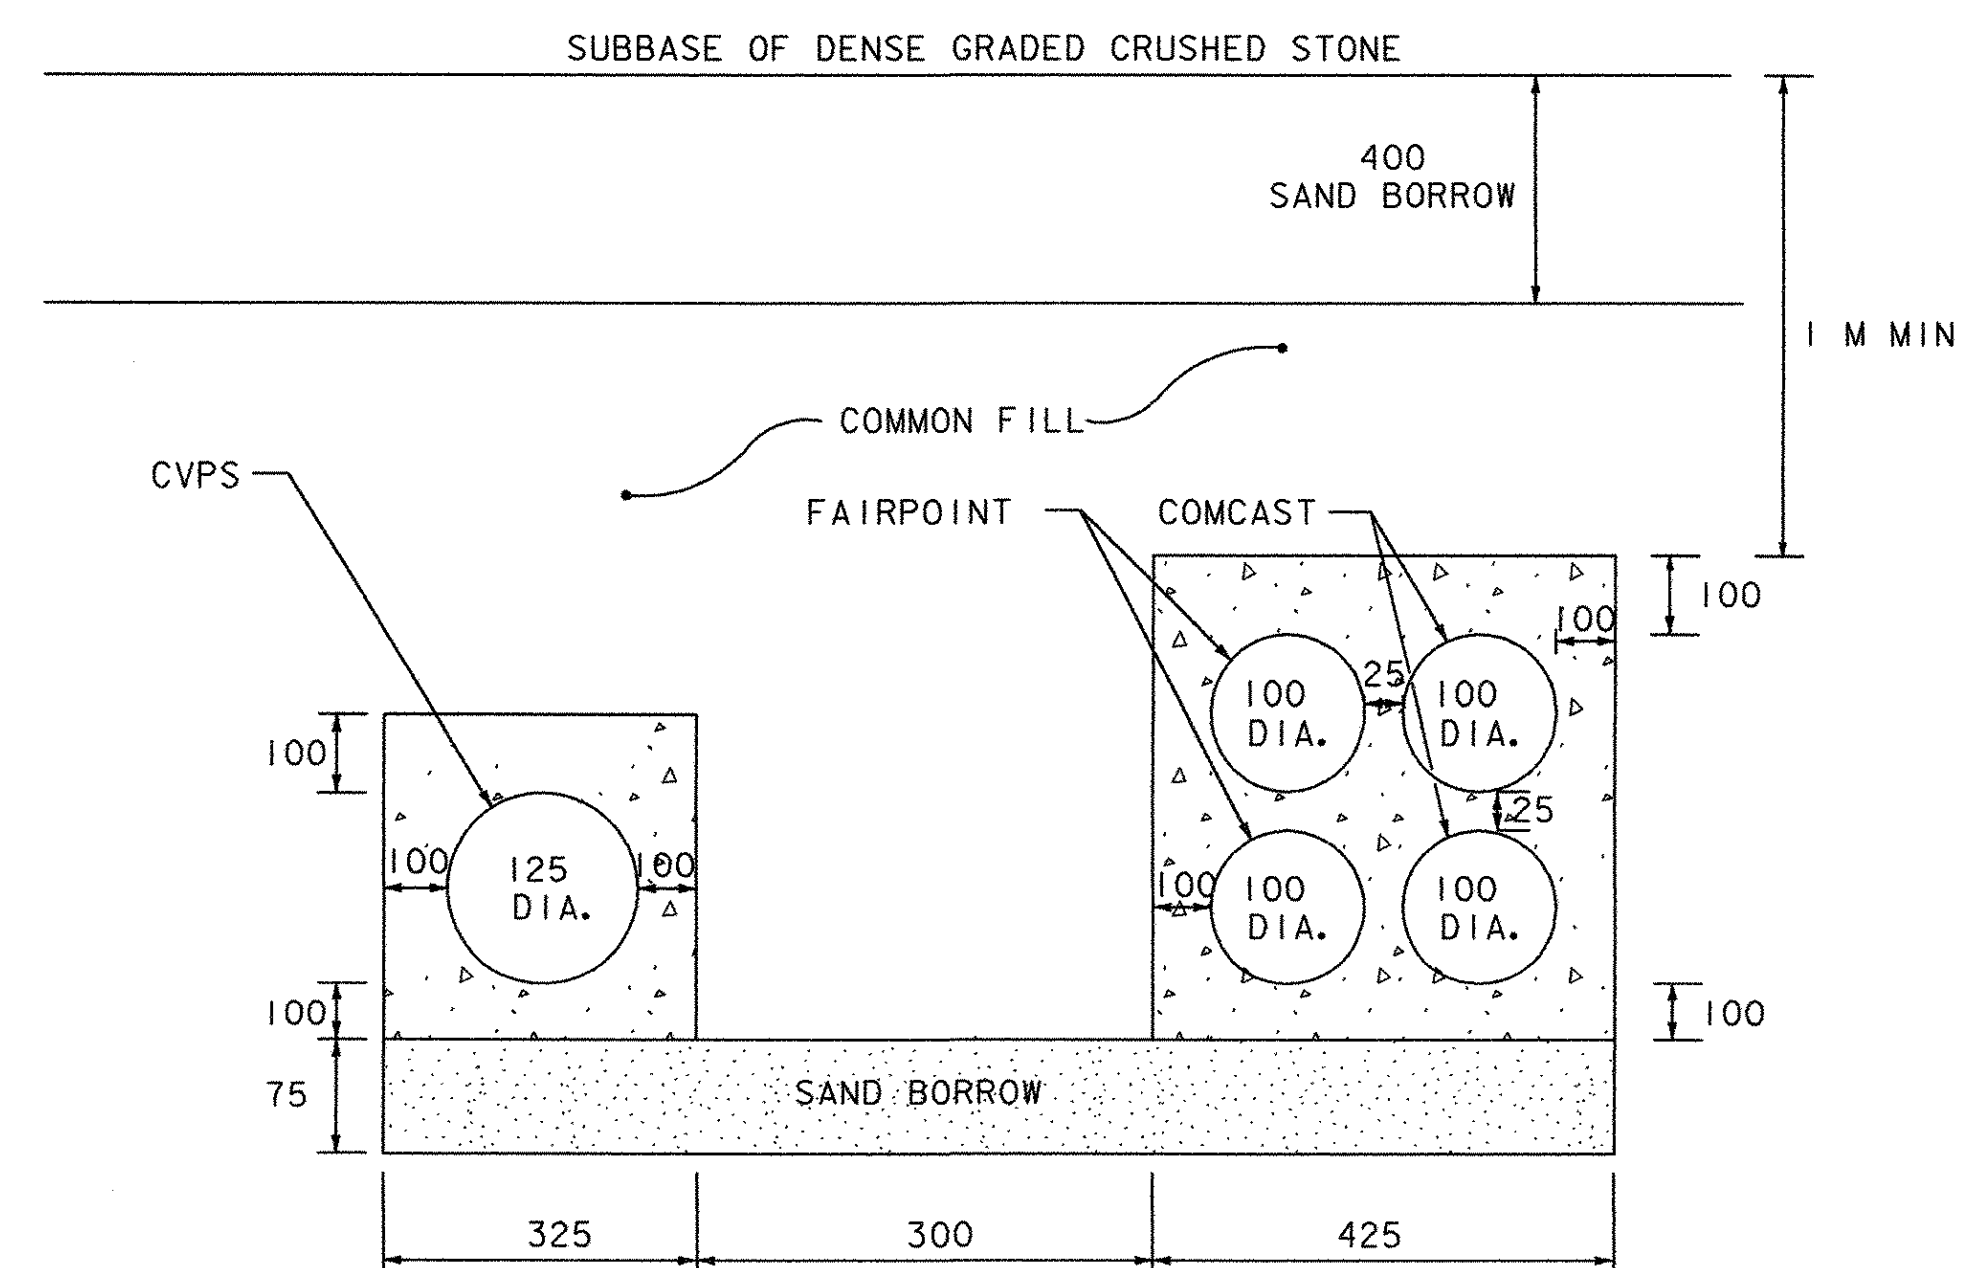

UTILITY DUCT BANK

(NOT TO SCALE)
 (TO BE PAID FOR AS SPECIAL PROVISION - (DUCT BANK))
 VT ROUTE 9 STA. 1+374 - 1+377
 (UTILITY POLE #4 TO UTILITY POLE #6)

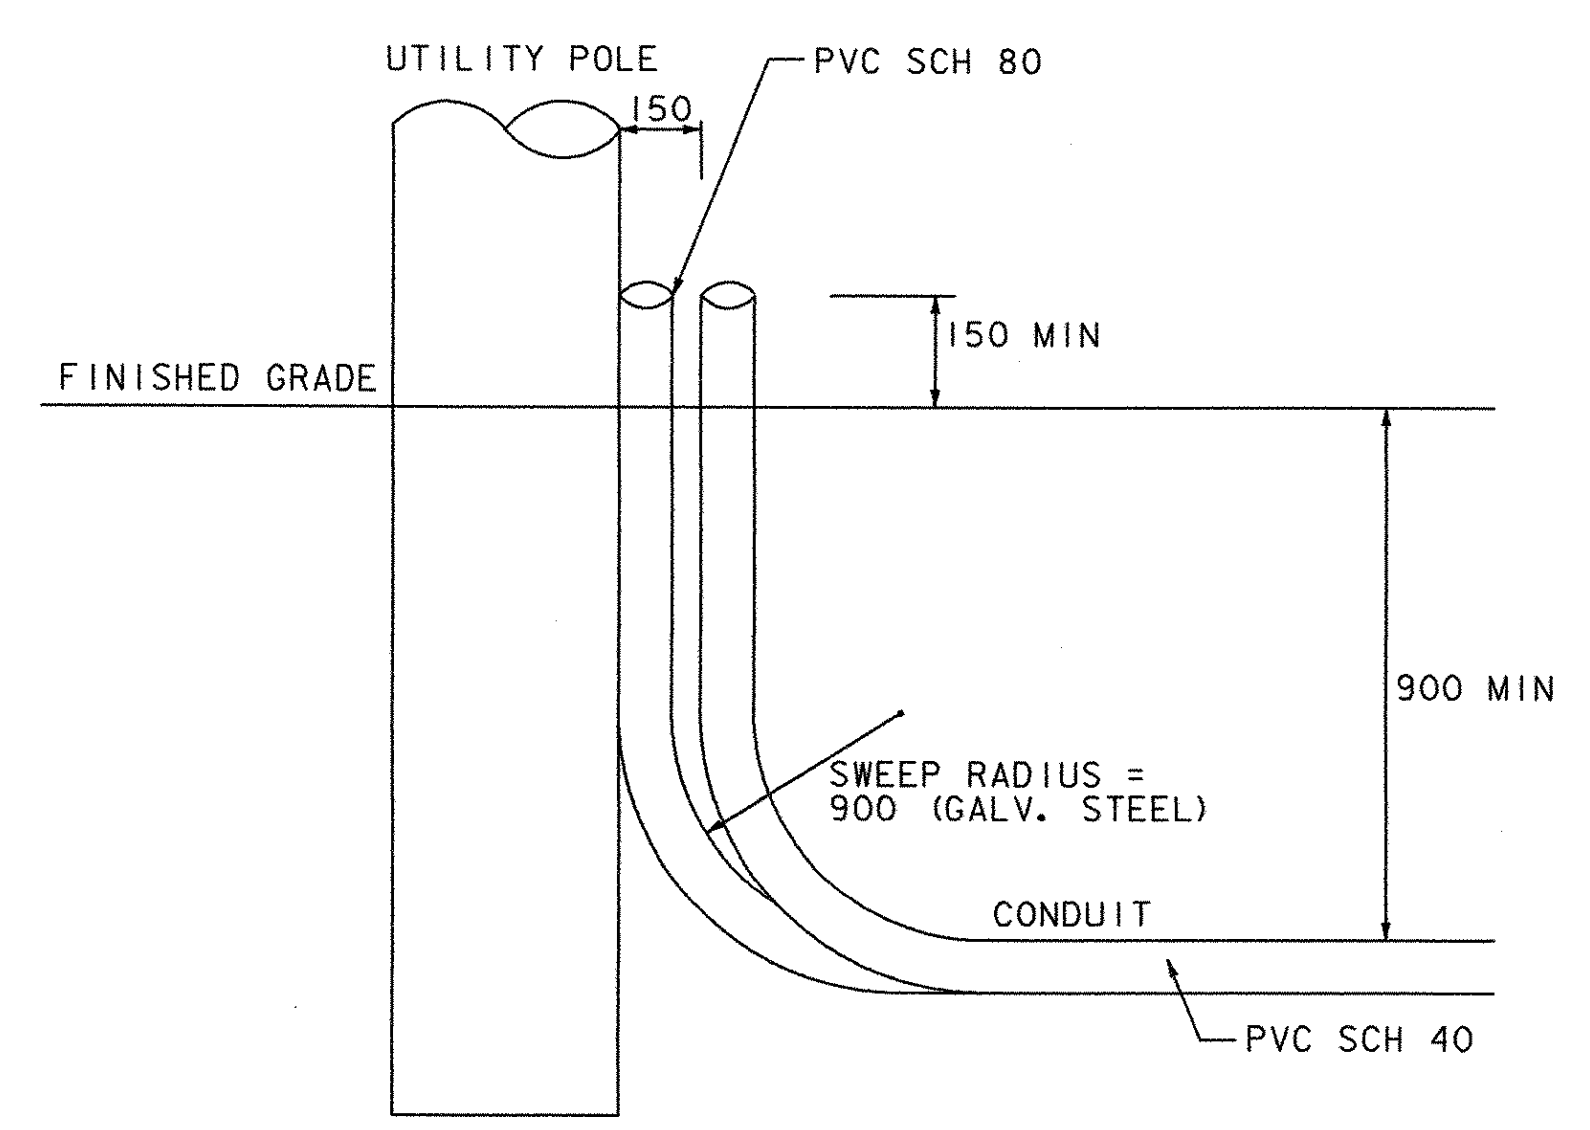

TYPICAL CONDUIT PLACEMENT ON POLE

(NOT TO SCALE)

VERMONT AGENCY OF TRANSPORTATION



PROJECT NAME: BENNINGTON	PLOT DATE: 1/30/2009
PROJECT NUMBER: AC NH 019-(51)	DRAWN BY: STANTEC
DESIGN SUPERVISOR: GREG EDWARDS	CHECKED BY: GARY SANTY
DESIGNED BY: MARC FOISY	SHEET 161 OF 367
UTILITY DETAILS U-05	

va:\953\active\9530002\transportation\drawing\contract_1\plot_files\z3d307\def_utl.prf