
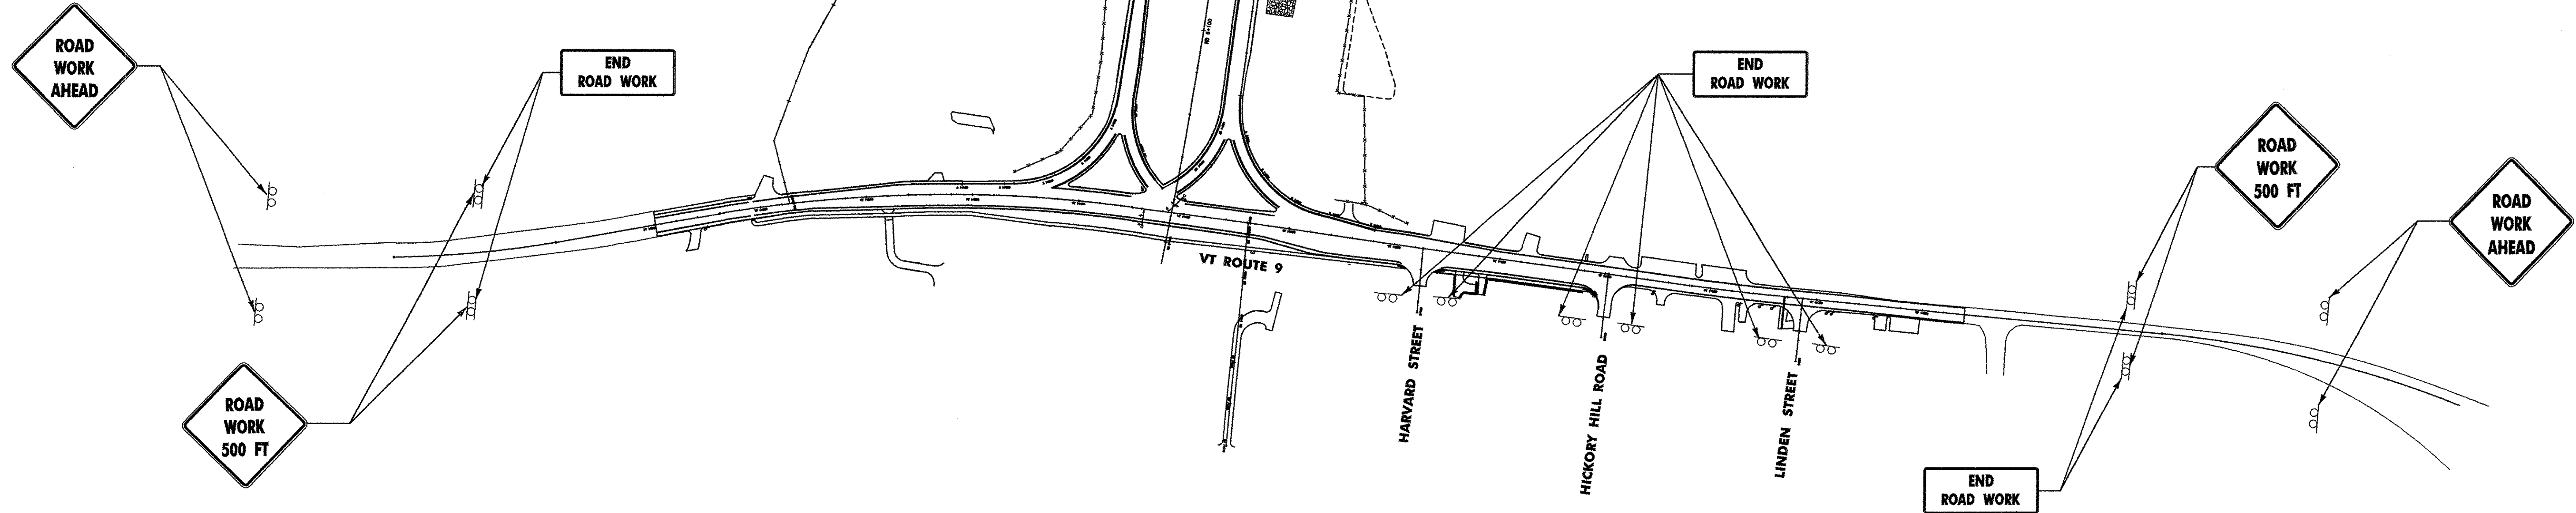
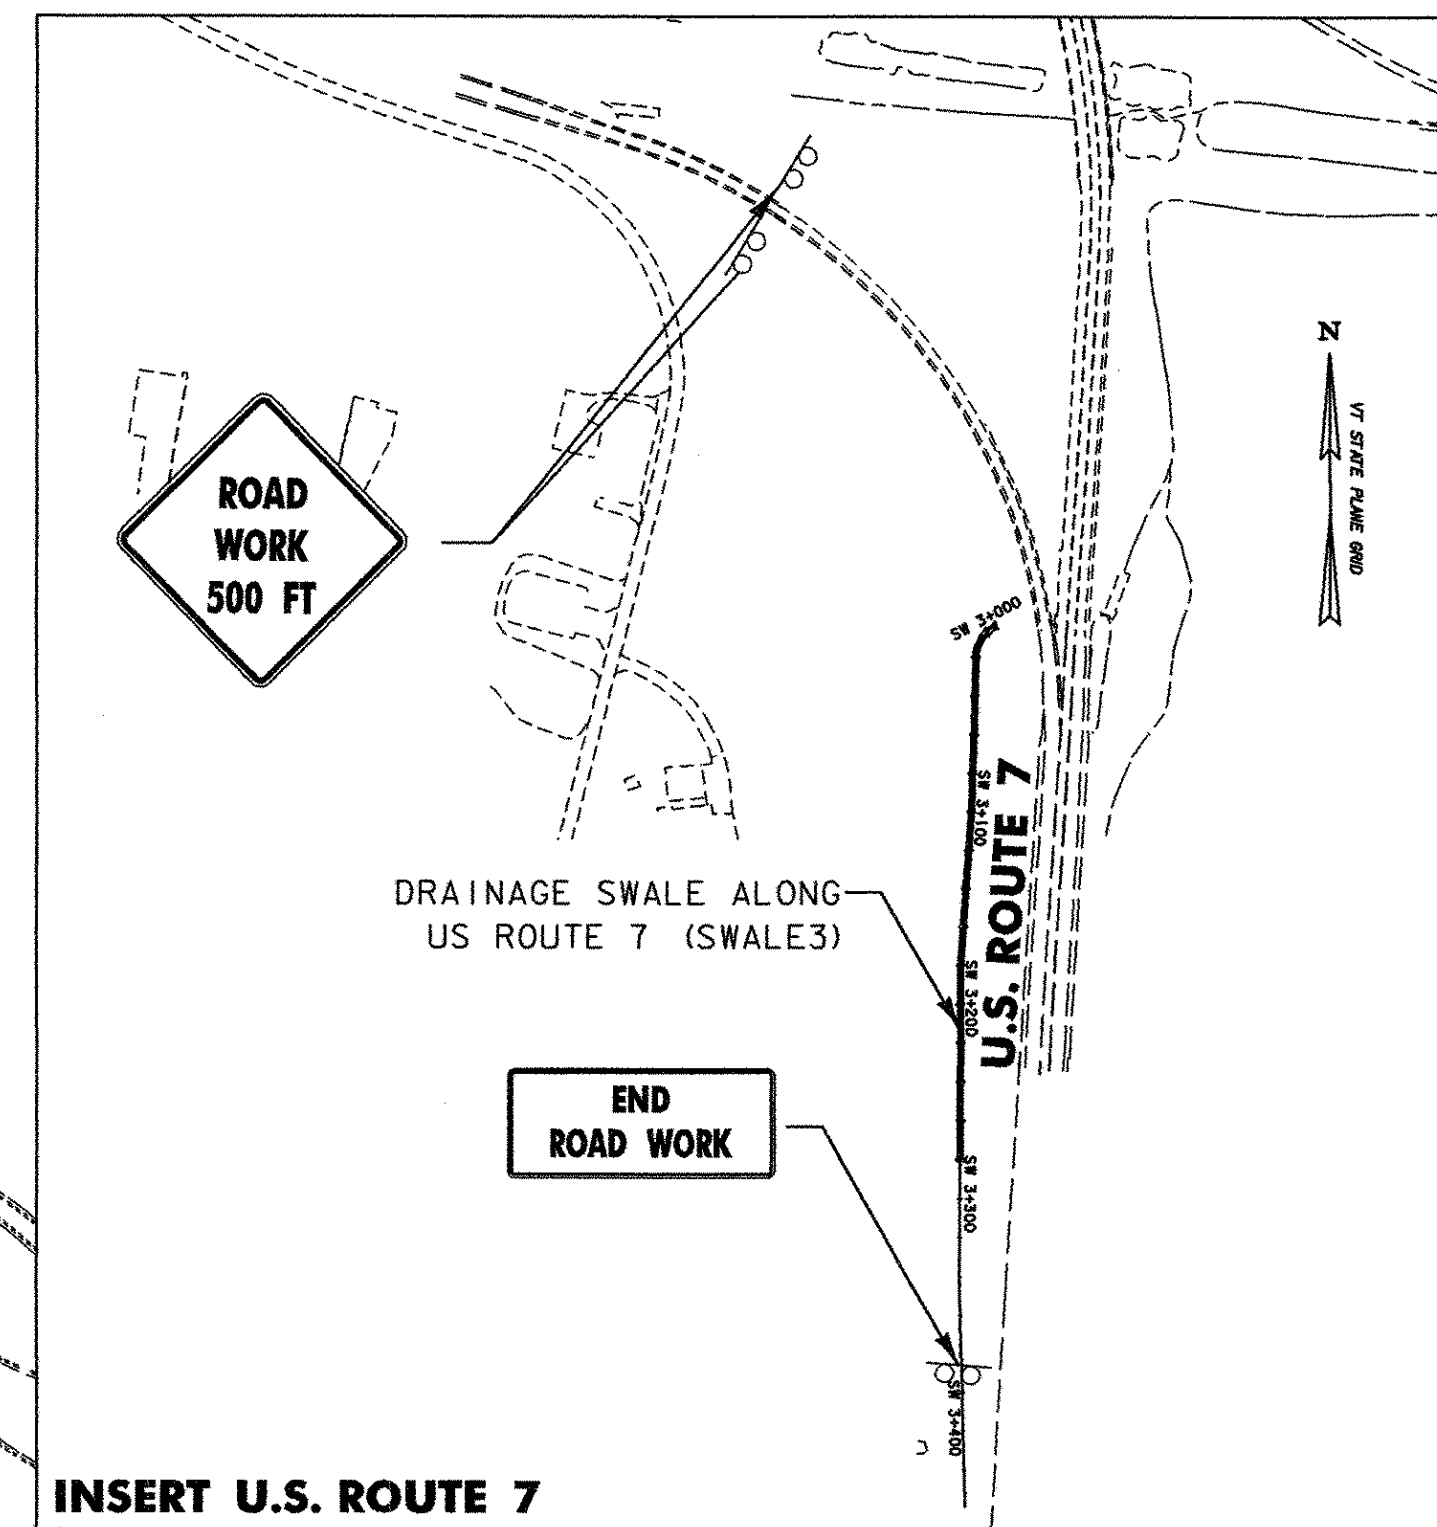
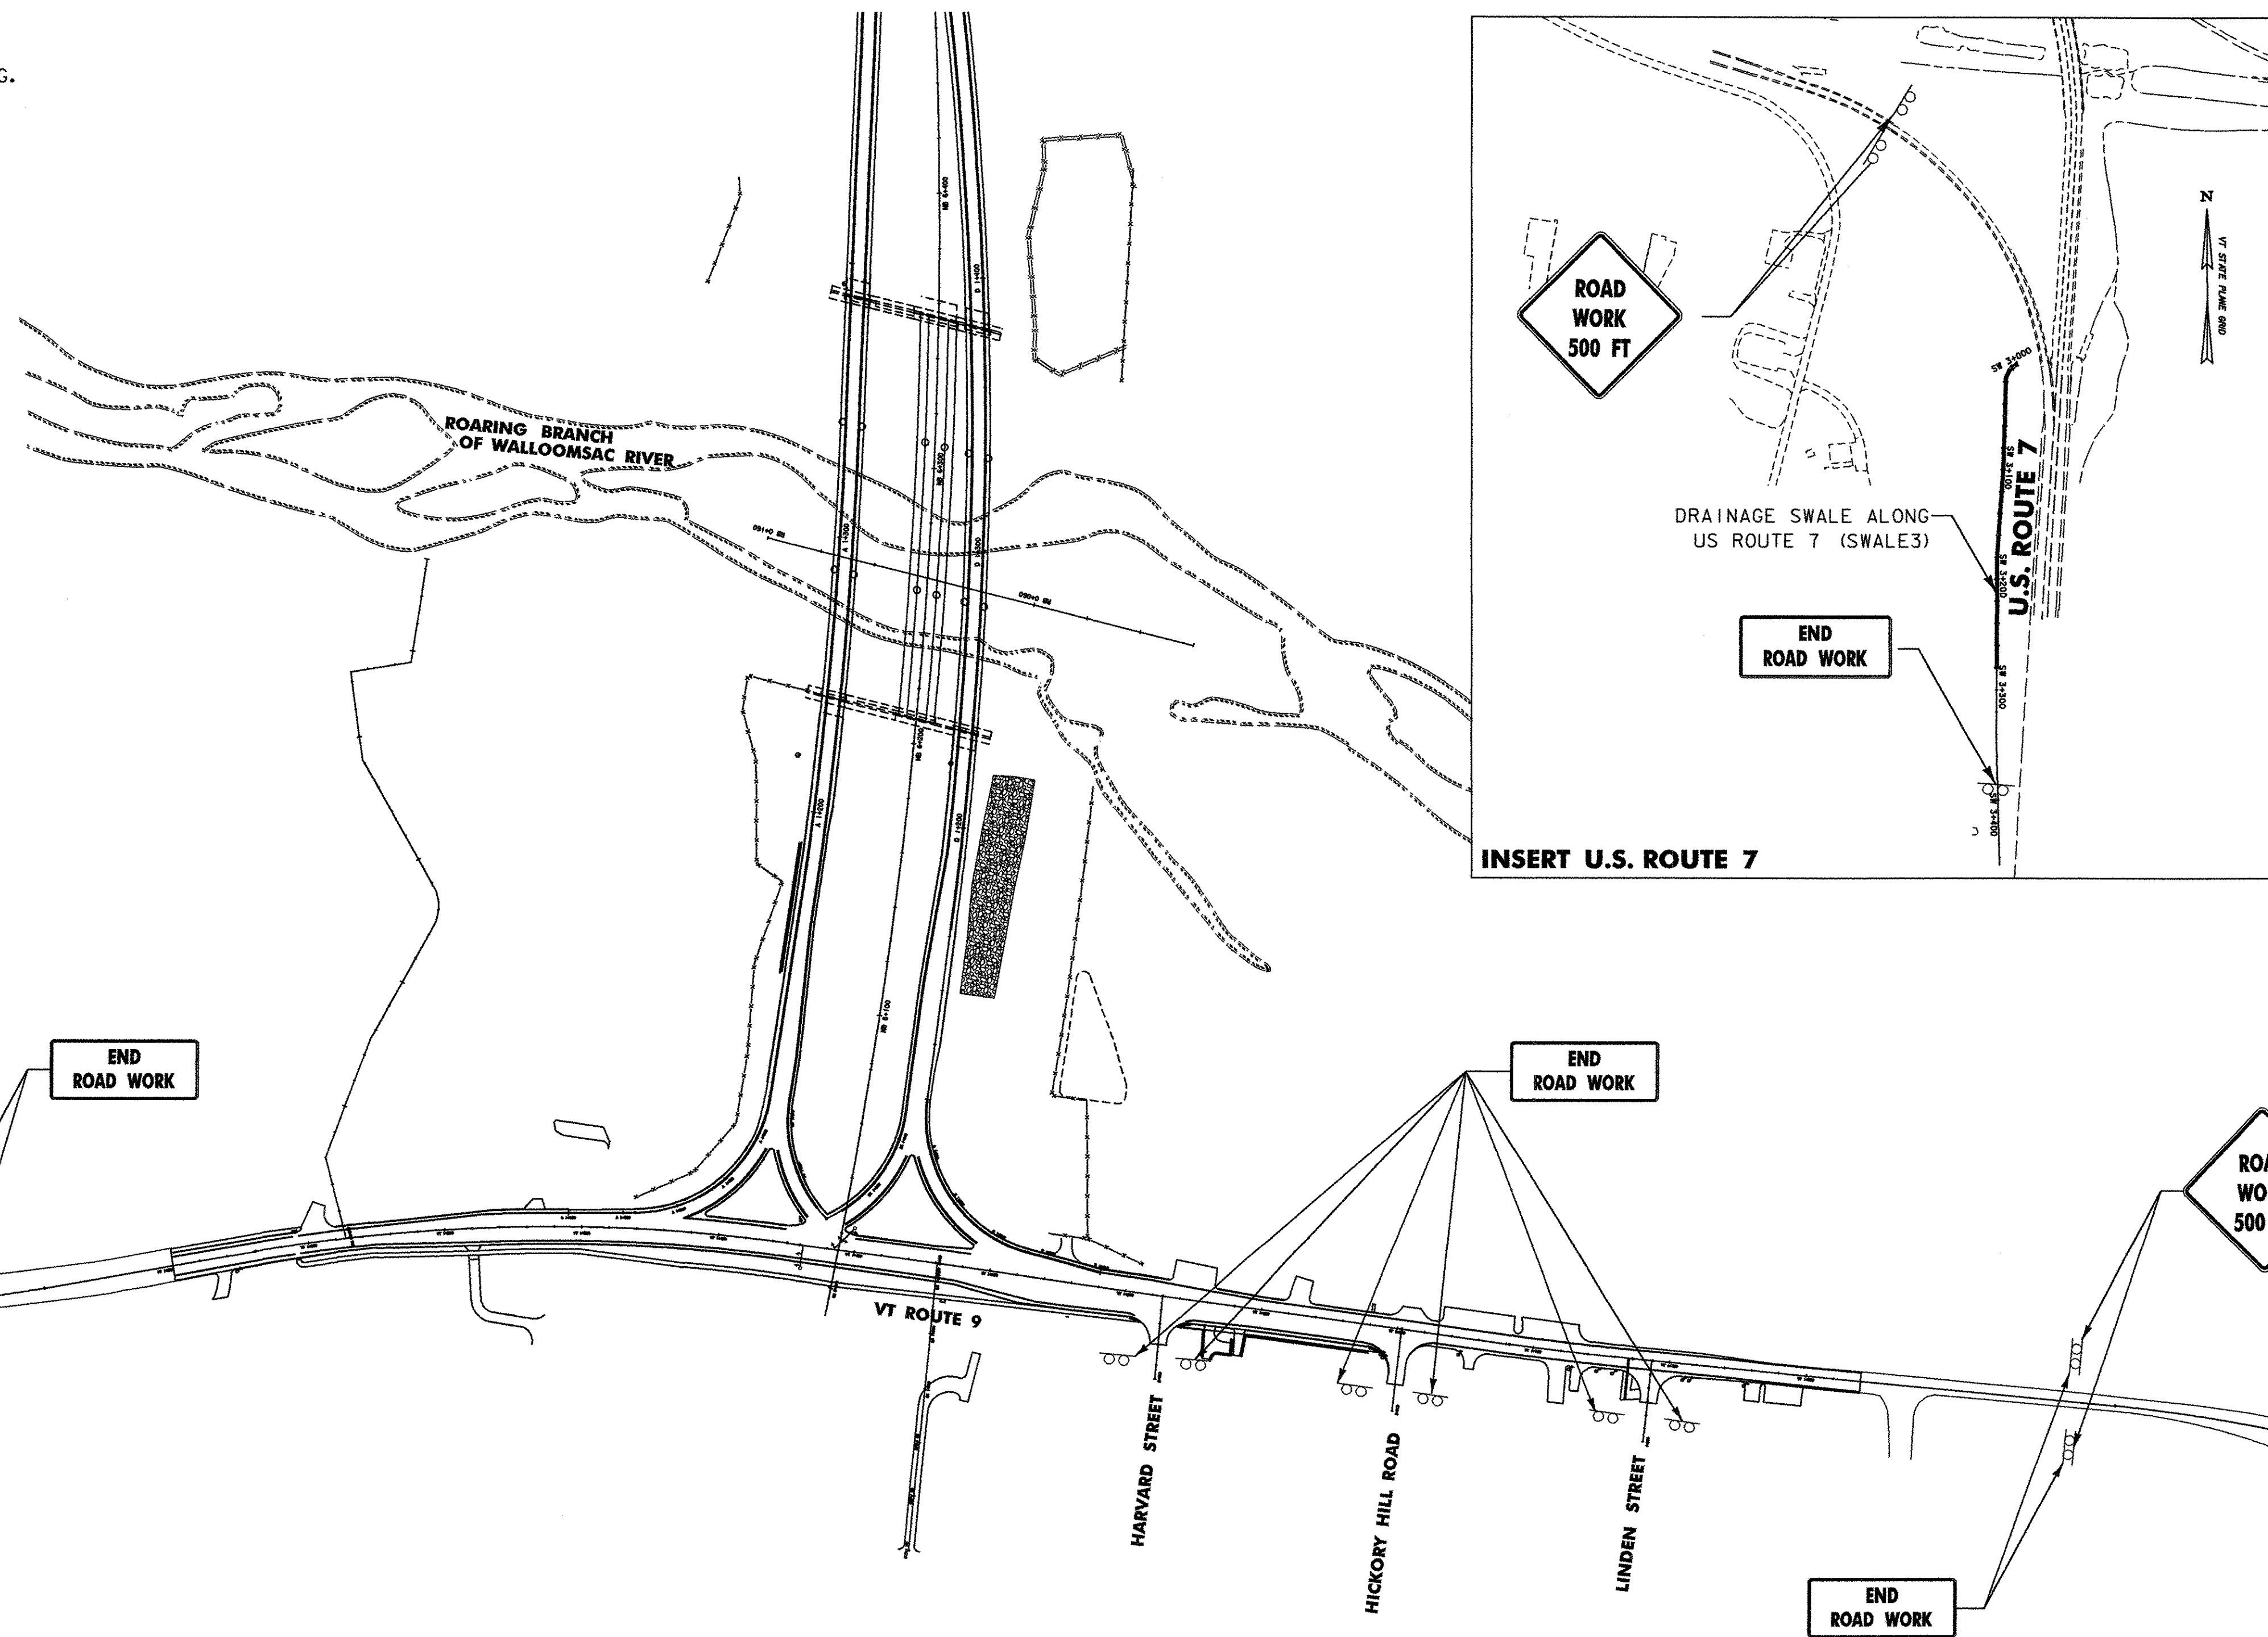


LEGEND

- ERW = END ROAD WORK
- RW500 = ROAD WORK 500 FT
- RWA = ROAD WORK AHEAD

LOCATION	ERW	RW500	RWA
VT ROUTE 9	4	4	4
HARVARD STREET	2	0	0
HICKORY HILL ROAD	2	0	0
LINDEN STREET	2	0	0
U.S. ROUTE 7 (INSERT)	1	2	0
TOTALS	11	6	4

NOTE: ALL SIGNS TO HAVE ASTM TYPE VIII SIGN SHEETING.

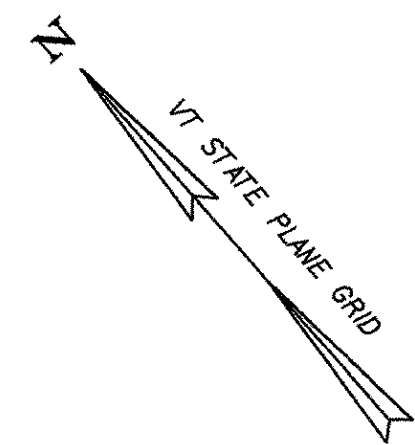

CONSTRUCTION APPROACH SIGNING
 NOT TO SCALE
 SEE VTrans STANDARD E - 100 FOR SIGN PLACEMENT

VERMONT AGENCY OF TRANSPORTATION



PROJECT NAME: BENNINGTON
 PROJECT NUMBER: AC NH 019-1(51)
 FILE NAME: ...\\plot files\zd307\clcas.ptf PLOT DATE: 1/30/2009
 DESIGN SUPERVISOR: GREG EDWARDS DRAWN BY: STANTEC
 DESIGNED BY: MARC FOISY CHECKED BY: GARY SANTY
CONSTRUCTION APPROACH SIGNING CAS-01 SHEET 164 OF 367

V:\1953\acrive\19530002\transportation\drawing\contract\plot files\zd307\clcas.ptf