
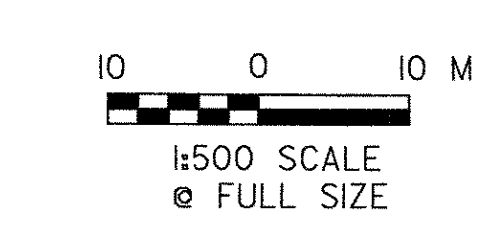


NOTE:
THIS SHEET TO BE USED FOR
LANDSCAPING INFORMATION ONLY

NOTES:
1. REFERENCE ROARING BRANCH BRIDGE PLANS FOR
DETAILS OF CONSTRUCTION BEYOND ROADWAY
LIMITS.

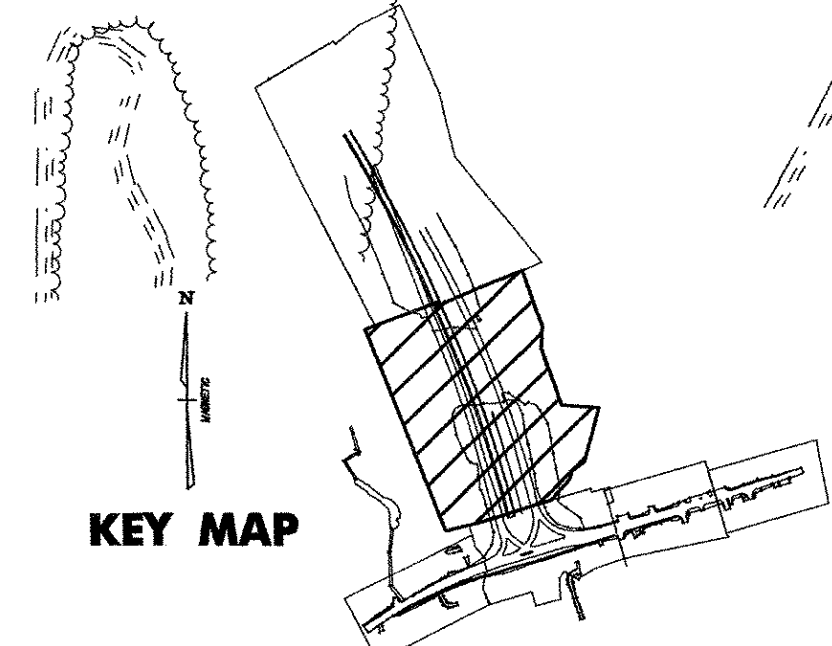

VERMONT AGENCY OF TRANSPORTATION

DuBois & King Inc.

| | |
|--|-----------------------|
| PROJECT NAME: BENNINGTON - NORTH | |
| PROJECT NUMBER: BENNINGTON AC NH 019-(K51) | |
| FILE NAME: ...\\dgn\zd307c\gen_plans_500.pff | PLOT DATE: 1/27/2009 |
| DESIGN SUPERVISOR: J. BENSON | DRAWN BY: E. SMALL |
| DESIGNED BY: J. STEELE/C. BRODIE | CHECKED BY: J. STEELE |
| LANDSCAPE PLAN L-03 | SHEET 169 OF 367 |

I:\R1463PC\confract_5\dgn\zd307c\gen_plans_500.pff