


MATCH LINE
STA. VT 1+700
SEE SHEET L-07

LEGEND

- DECIDUOUS TREE GROUPING WITH PLANT TYPE AND QUANTITY
- EVERGREEN TREE GROUPING WITH PLANT TYPE AND QUANTITY
- EXISTING DECIDUOUS TREE
- EXISTING EVERGREEN TREE
- TOE OF SLOPE
- LIMIT OF CUT
- APPROXIMATE ULTIMATE TOE OF SLOPE
- APPROXIMATE ULTIMATE LIMIT OF CUT
- TREELINE
- R.O.W.

NOTE:
THIS SHEET TO BE USED FOR
LANDSCAPING INFORMATION ONLY

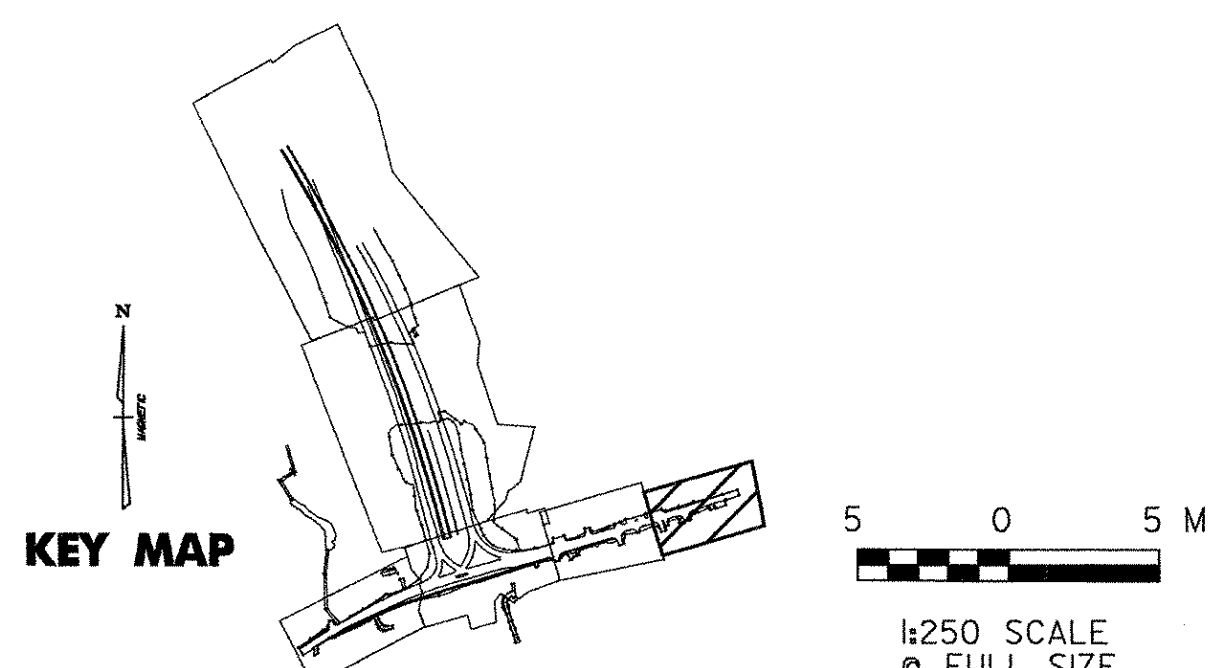

VERMONT AGENCY OF TRANSPORTATION	
DuBois & King inc.	
PROJECT NAME: BENNINGTON - NORTH	PLOT DATE: 1/27/2009
PROJECT NUMBER: BENNINGTON AC NH 019-1(51)	DRAWN BY: E. SMALL
FILE NAME: ...dgn\zd307c\gen_plans_250.pxf	CHECKED BY: J. STEELE
DESIGN SUPERVISOR: J. BENSON	DESIGNED BY: J. STEELE/C. BRODIE
LANDSCAPE PLAN L-08	
SHEET 174 OF 367	

R:\RIS463FC\cont\cct_5\vgp\zd307c\gen_plans_250.pxf