



\* - DIMENSION SHOWN IS ALONG THE FRONT FACE OF THE RETAINING WALL, THE ACTUAL RAIL DIMENSION MAY VARY.

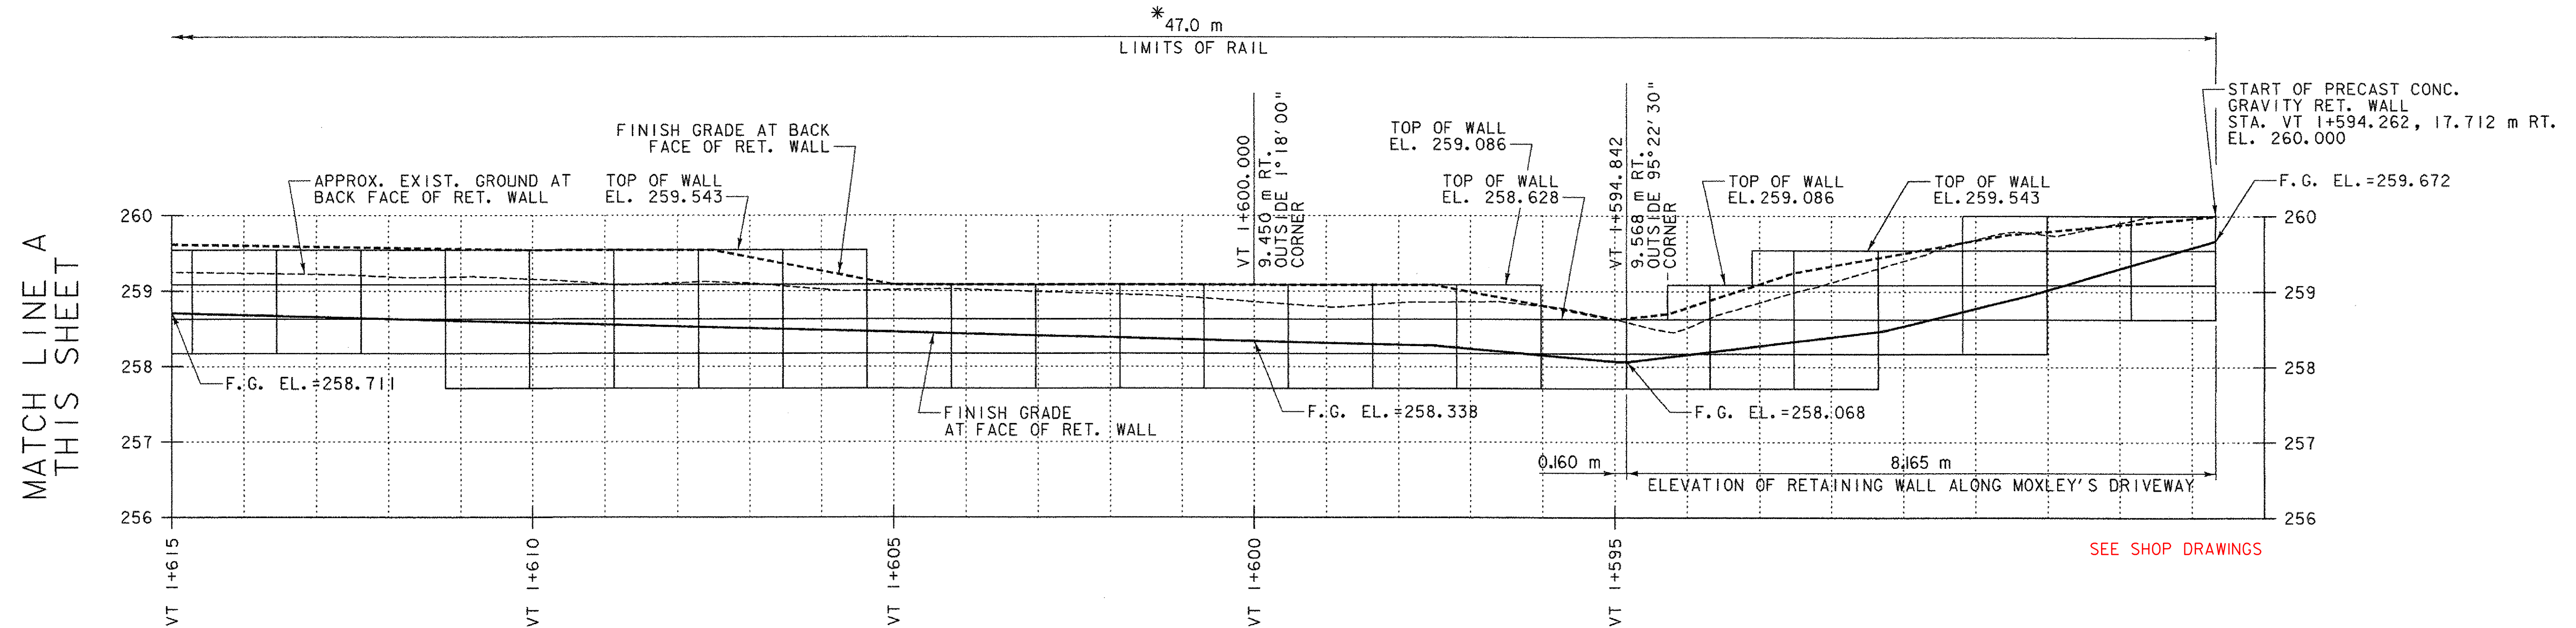

**MOXLEY - GARDNER RETAINING WALL ELEVATION**

\* - DIMENSION SHOWN IS ALONG THE FRONT FACE OF THE RETAINING WALL, THE ACTUAL RAIL DIMENSION MAY VARY.

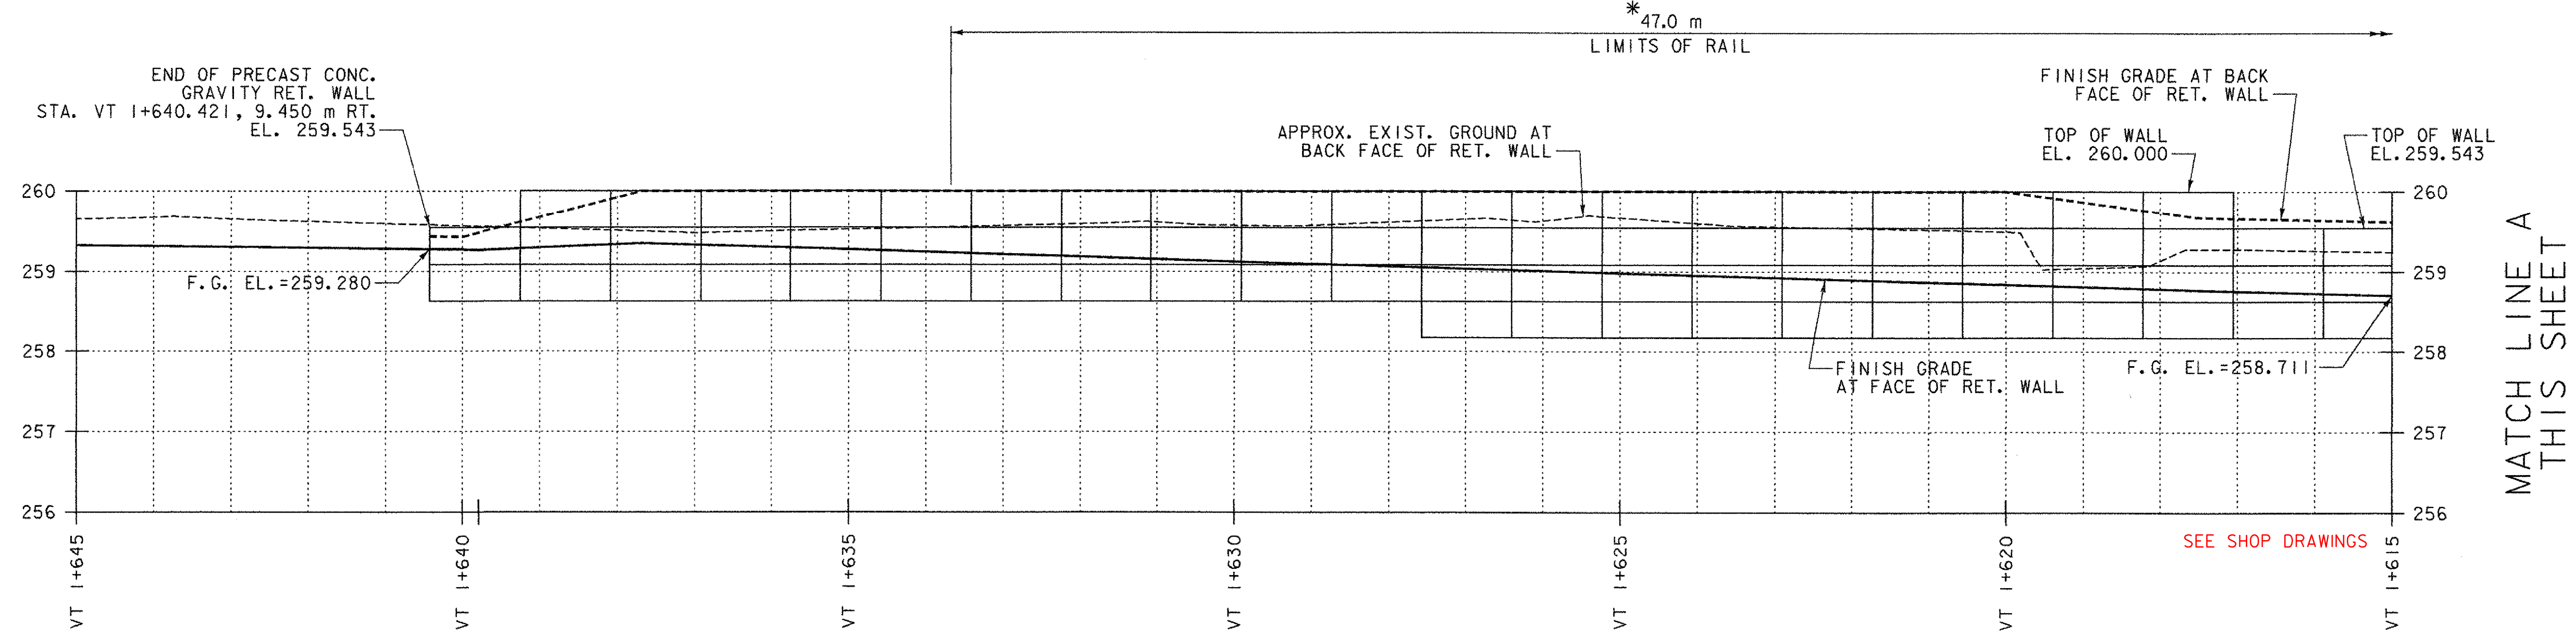

**MOXLEY - GARDNER RETAINING WALL ELEVATION**

**VERMONT AGENCY OF TRANSPORTATION**



PROJECT NAME:	BENNINGTON
PROJECT NUMBER:	AC NH 019-1(51)
FILE NAME:	...plot files\zd307cbwd.plt
DESIGN SUPERVISOR:	GREG EDWARDS
DESIGNED BY:	SCOTT BURBANK
<b>BLOCK WALL DETAIL BWD-04</b>	
PLOT DATE:	2/2/2009
DRAWN BY:	STANTEC
CHECKED BY:	MIKE CHENETTE
SHEET	179 OF 367

V:\1953\ver\1953002\Transportation\Drawings\contractor\1\plot files\zd307cbwd.plt