


STATIONING ←

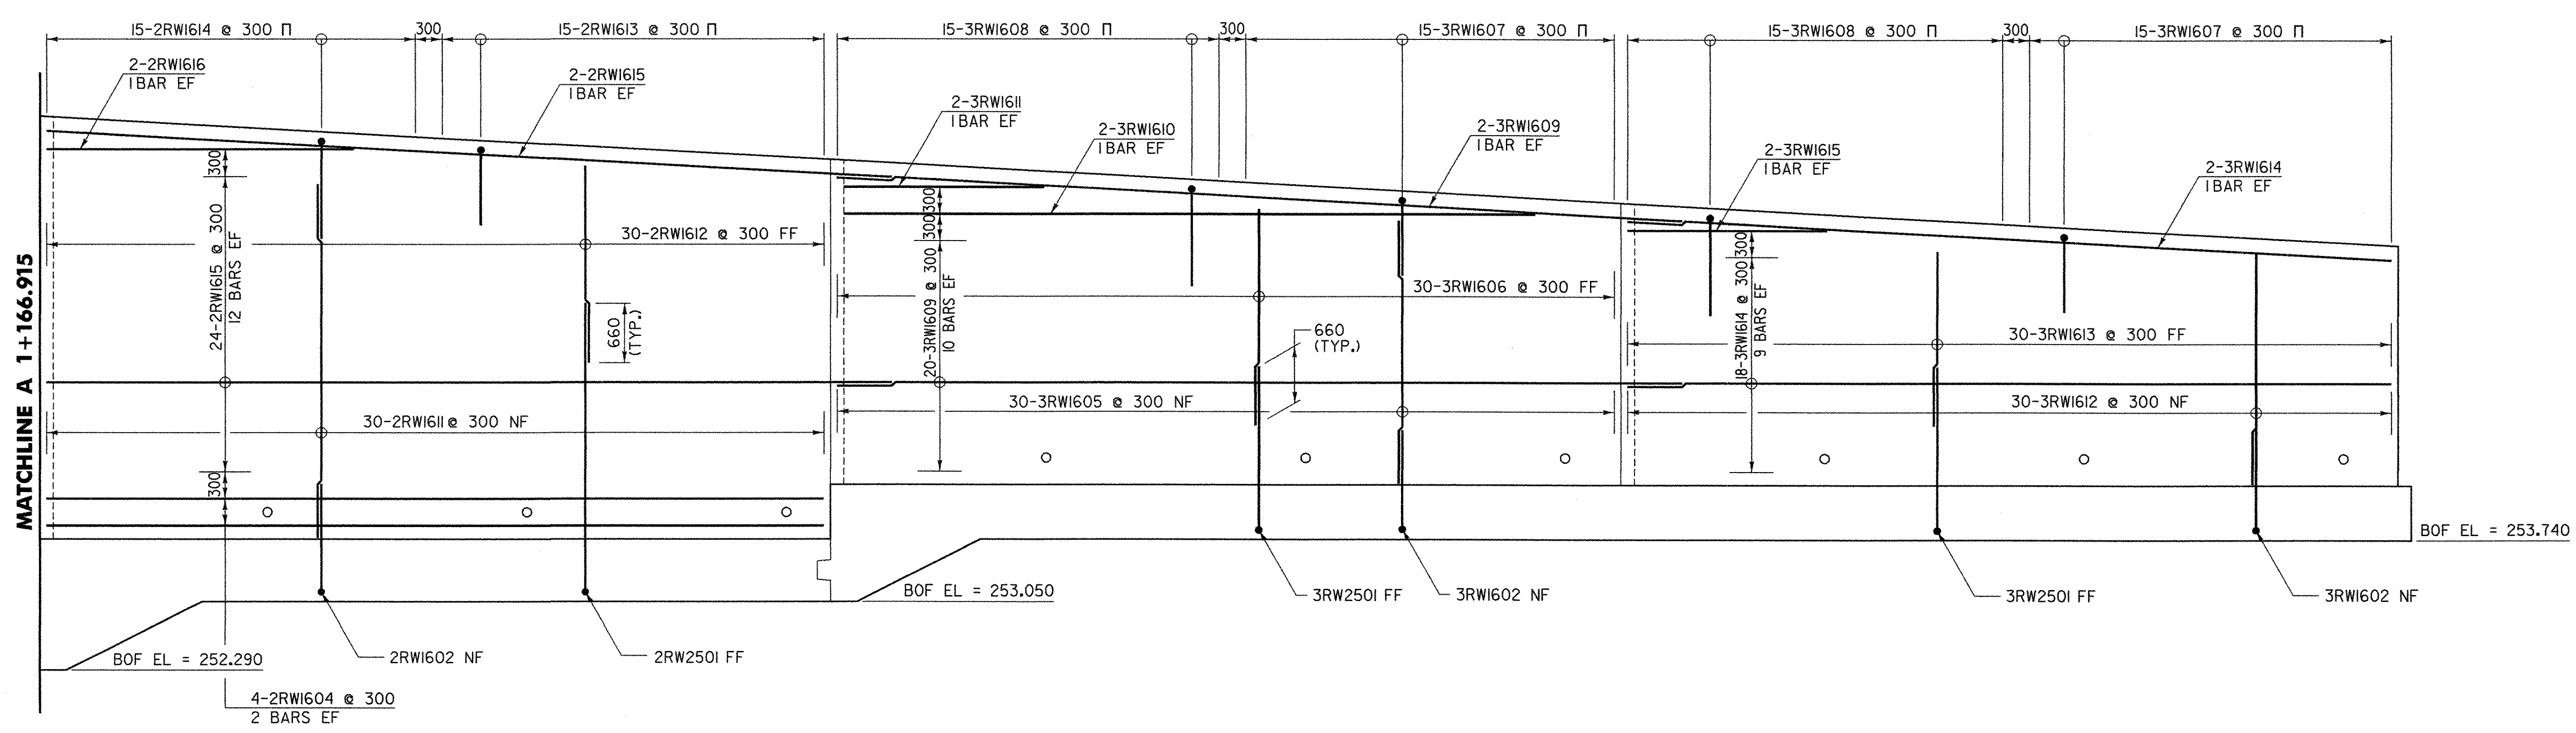

**NOTE:**

- NF = NEAR FACE
- FF = FAR FACE
- EF = EACH FACE
- ▲ = CUT TO FIT IN FIELD
- 75 CLR. UNLESS OTHERWISE NOTED ON THE PLANS.

<b>VERMONT AGENCY OF TRANSPORTATION</b>	
	PROJECT NAME: BENNINGTON
	PROJECT NUMBER: AC NH 019-(151)
FILE NAME: ...plot files\zd307clcvps_05.ptf	PLOT DATE: 2/2/2009
DESIGN SUPERVISOR: GREG EDWARDS	DRAWN BY: STANTEC
DESIGNED BY: SCOTT BURBANK	CHECKED BY: MIKE CHENETTE
<b>CVPS RET. WALL REINF. ELEV. CVPS-05</b>	SHEET 184 OF 367

v:\953\active\19530002\transportation\drawing\contract\plot files\zd307clcvps\_05.ptf