



INDEX OF SHEETS


BRIDGE SHEET NO.	SHEET	DRAWING TITLE
BR200	187	INDEX OF SHEETS
BR201	188	PRELIMINARY INFORMATION SHEET
BR202	189	REINFORCED SOIL SLOPE DETAILS
BR203	190	QUANTITY SHEET (1 OF 2)
BR204	191	QUANTITY SHEET (2 OF 2)
BR205	192	BORING INFORMATION (SHEET 1 OF 2)
BR206	193	BORING INFORMATION (SHEET 2 OF 2)
BR207	194	BORING LOGS (1 OF 33)
BR208	195	BORING LOGS (2 OF 33)
BR209	196	BORING LOGS (3 OF 33)
BR239	226	BORING LOGS (33 OF 33)
BR240	227	GENERAL PLAN
BR241	228	ABUTMENT 1 - PLAN AND ELEVATION
BR242	229	ABUTMENT 2 - PLAN AND ELEVATION
BR243	230	PIER PLAN AND ELEVATION (ODD PIERS)
BR244	231	PIER PLAN AND ELEVATION (EVEN PIERS)
BR245	232	GENERAL NOTES
BR246	233	ELEVATION (VT ROUTE 279)
BR247	234	LAYOUT DIAGRAM (VT ROUTE 279)
BR248	235	ABUTMENT 1 MASONRY (VT ROUTE 279)
BR249	236	ABUTMENT 1 REINFORCEMENT PLANS (VT ROUTE 279)
BR250	237	ABUTMENT 1 REINFORCEMENT DETAILS (VT ROUTE 279)
BR251	238	ABUTMENT 2 MASONRY (VT ROUTE 279)
BR252	239	ABUTMENT 2 REINFORCEMENT PLANS (VT ROUTE 279)
BR253	240	ABUTMENT 2 REINFORCEMENT DETAILS (VT ROUTE 279)
BR254	241	ABUTMENT 1 MASONRY (SB VT ROUTE 279)
BR255	242	ABUTMENT 1 REINFORCEMENT PLANS (SB VT ROUTE 279)
BR256	243	ABUTMENT 1 REINFORCEMENT DETAILS (SB VT ROUTE 279)
BR257	244	ABUTMENT 2 MASONRY (SB VT ROUTE 279)
BR258	245	ABUTMENT 2 REINFORCEMENT PLANS (SB VT ROUTE 279)
BR259	246	ABUTMENT 2 REINFORCEMENT DETAILS (SB VT ROUTE 279)
BR260	247	ELEVATION (RAMP A)
BR261	248	TRANSVERSE SECTION (RAMP A)
BR262	249	DECK REINFORCEMENT (RAMP A)
BR263	250	RAILING LAYOUT (RAMP A)
BR264	251	FRAMING PLAN (SHEET 1 OF 2) (RAMP A)
BR265	252	FRAMING PLAN (SHEET 2 OF 2) (RAMP A)
BR266	253	GIRDER ELEVATION (RAMP A)
BR267	254	GIRDER TABLES (RAMP A)
BR268	255	SPLICE DETAILS (RAMPS A AND D)
BR269	256	STEEL DETAILS (SHEET 1 OF 2) (RAMPS A AND D)
BR270	257	STEEL DETAILS (SHEET 2 OF 2) (RAMPS A AND D)

BRIDGE SHEET NO.	SHEET
BR271	258
BR272	259
BR273	260
BR331	318

DRAWING TITLE
ABUTMENT 1 MASONRY (RAMP A)
ABUTMENT 1 REINFORCEMENT PLANS (RAMP A)
ABUTMENT 1 REINFORCEMENT DETAILS (RAMP A)
ABUTMENT 2 MASONRY (RAMP A)
ABUTMENT 2 REINFORCEMENT PLANS (RAMP A)
ABUTMENT 2 REINFORCEMENT DETAILS (RAMP A)
PIER 7 MASONRY (RAMP A)
PIER 8 MASONRY (RAMP A)
PIER 7 REINFORCEMENT (RAMP A)
PIER 8 REINFORCEMENT (RAMP A)
ELEVATION (RAMP D)
TRANSVERSE SECTION (RAMP D)
DECK REINFORCEMENT (RAMP D)
RAILING LAYOUT (RAMP D)
FRAMING PLAN (SHEET 1 OF 2) (RAMP D)
FRAMING PLAN (SHEET 2 OF 2) (RAMP D)
GIRDER ELEVATION (RAMP D)
GIRDER TABLES (RAMP D)
ABUTMENT 1 MASONRY (RAMP D)
ABUTMENT 1 REINFORCEMENT PLANS (RAMP D)
ABUTMENT 1 REINFORCEMENT DETAILS (RAMP D)
ABUTMENT 2 MASONRY (RAMP D)
ABUTMENT 2 REINFORCEMENT PLANS (RAMP D)
ABUTMENT 2 REINFORCEMENT DETAILS (RAMP D)
PIER 1 MASONRY (RAMP D)
PIER 2 MASONRY (RAMP D)
PIER 1 REINFORCEMENT (RAMP D)
PIER 2 REINFORCEMENT (RAMP D)
DRILLED SHAFT DETAILS (VT ROUTE 279)
DRILLED SHAFT DETAILS (RAMP A AND D)
ABUTMENT 1 FIXED BEARING DETAILS
PIER EXPANSION BEARING DETAILS
ABUTMENT 2 EXPANSION BEARING DETAILS
BEARING ALIGNMENT DIAGRAMS
TYPICAL BRIDGE DETAILS
MODULAR JOINT PLAN
MODULAR JOINT DETAILS
APPROACH SLAB LAYOUT AND DETAILS
TYPICAL SCUPPER DETAILS
BRIDGE RAILING - NETC 2 RAIL
BRIDGE RAILING - NETC 2 RAIL - THREE BEAM APPROACH RAIL
BRIDGE RAILING - NETC 2 RAIL - THREE BEAM APPROACH RAIL
BRIDGE RAILING - SNOW FENCE DETAILS FOR NETC 2 - RAIL
REINFORCING STEEL SCHEDULE (SHEET 1 OF 6)
REINFORCING STEEL SCHEDULE (SHEET 2 OF 6)
REINFORCING STEEL SCHEDULE (SHEET 3 OF 6)
REINFORCING STEEL SCHEDULE (SHEET 4 OF 6)
REINFORCING STEEL SCHEDULE (SHEET 5 OF 6)
REINFORCING STEEL SCHEDULE (SHEET 6 OF 6)
CHANNEL CROSS SECTION (1 OF 12)
CHANNEL CROSS SECTION (2 OF 12)
CHANNEL CROSS SECTION (3 OF 12)
CHANNEL CROSS SECTION (4 OF 12)
CHANNEL CROSS SECTION (5 OF 12)
CHANNEL CROSS SECTION (6 OF 12)
CHANNEL CROSS SECTION (7 OF 12)
CHANNEL CROSS SECTION (8 OF 12)
CHANNEL CROSS SECTION (9 OF 12)
CHANNEL CROSS SECTION (10 OF 12)
CHANNEL CROSS SECTION (11 OF 12)
CHANNEL CROSS SECTION (12 OF 12)

STANDARD SHEETS

B-5	01/03/2000
E-134	08/08/1995
E-191	02/01/1999

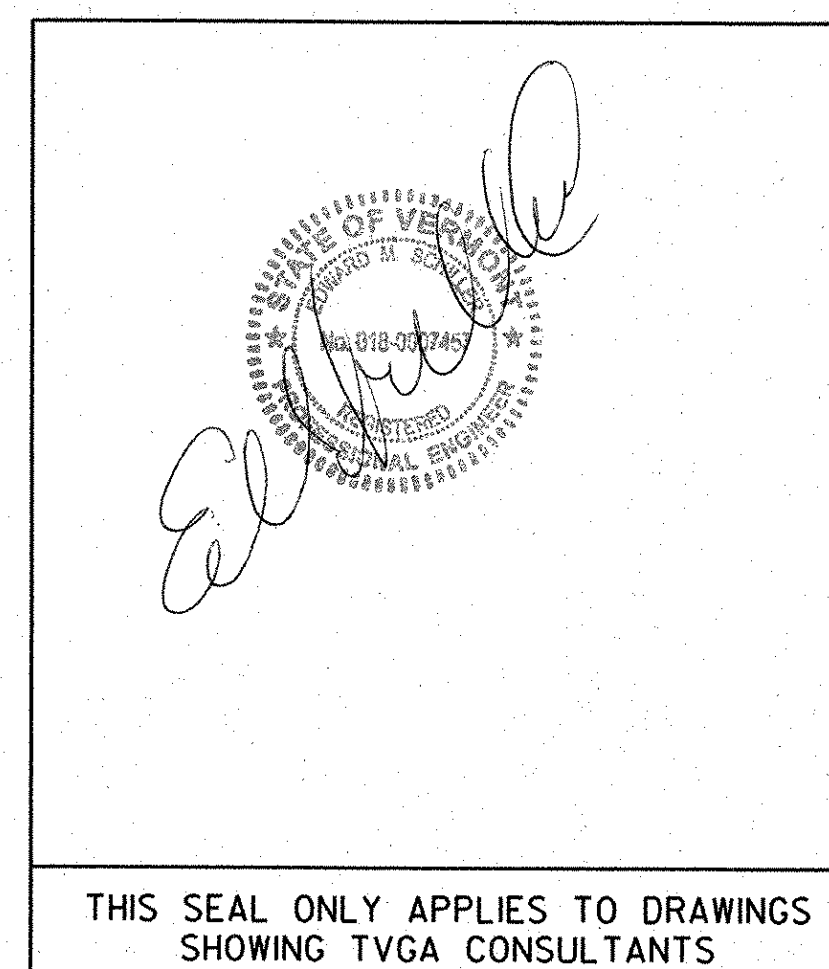

TVGA
CONSULTANTS

STATE OF VERMONT AGENCY OF TRANSPORTATION	
Town Of	BENNINGTON
Highway No.	VT RTE 279
Log Sta.	
Surv. Sta.	
VT ROUTE 279 & RAMPS OVER ROARING BRANCH OF WALLOOMSAC RIVER	
INDEX OF SHEETS	
Designed By	J.J. MANUSE
Checked By	B.J. CARLSON
Date	06/08
Drawn By	D.W. SHAFFER
Bridge Design Supervisor	K.M. WOJTKOWSKI
Date	06/08
PROJECT	BENNINGTON
PROJECT NO.	AC NH 019-1(51)
TVGA CAD Drawing No.	Index.dgn
Date	02/02/2009
Bridge Sheet No.	BR200
Sheet	187 of 367

THIS SEAL ONLY APPLIES TO DRAWINGS
SHOWING TVGA CONSULTANTS