



PLAN
SCALE 1:100

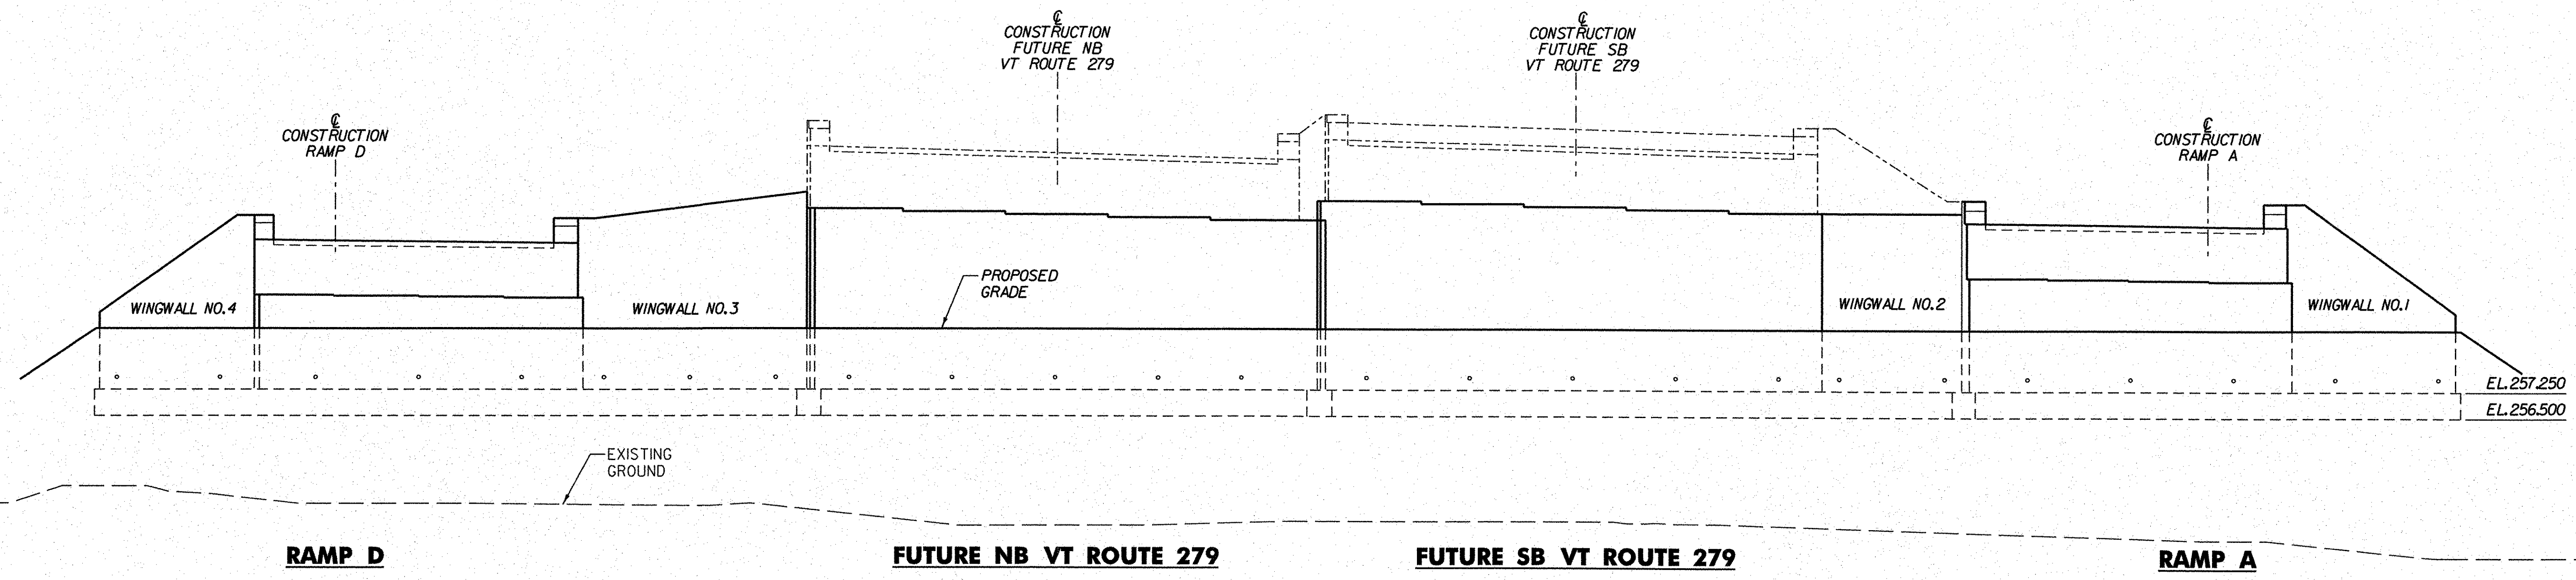

ELEVATION (LOOKING SOUTH)
SCALE 1:100

LEGEND:
 FUTURE CONSTRUCTION (NOT CONSTRUCTED AS PART OF THIS CONTRACT)

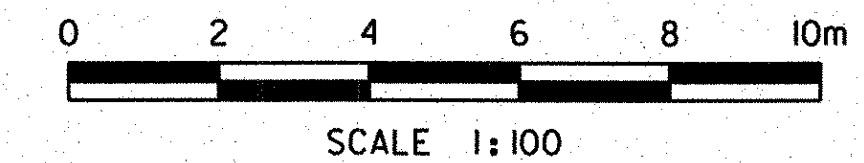

STATE OF VERMONT AGENCY OF TRANSPORTATION	
Town Of BENNINGTON	Bridge No. B15, B15N, B15S
Highway No. VT RTE 279	Log Sta. Surv. Sta.
VT ROUTE 279 & RAMPS OVER ROARING BRANCH OF WALLOOMSAC RIVER	
ABUTMENT 1 - PLAN AND ELEVATION	
Designed By B.J. CARLSON	Drawn By D.S. URBINO
Checked By K.M. WOJTKOWSKI 06/08	Date Bridge Design Supervisor K.M. WOJTKOWSKI Date 06/08
PROJECT BENNINGTON	PROJECT NO. AC NH 019-1(51)
TVGA CAD Drawing No. AbutElev.dgn	Date 02/02/2009
Bridge Sheet No. BR241	Sheet 228 of 367

