


PLAN
SCALE 1:100

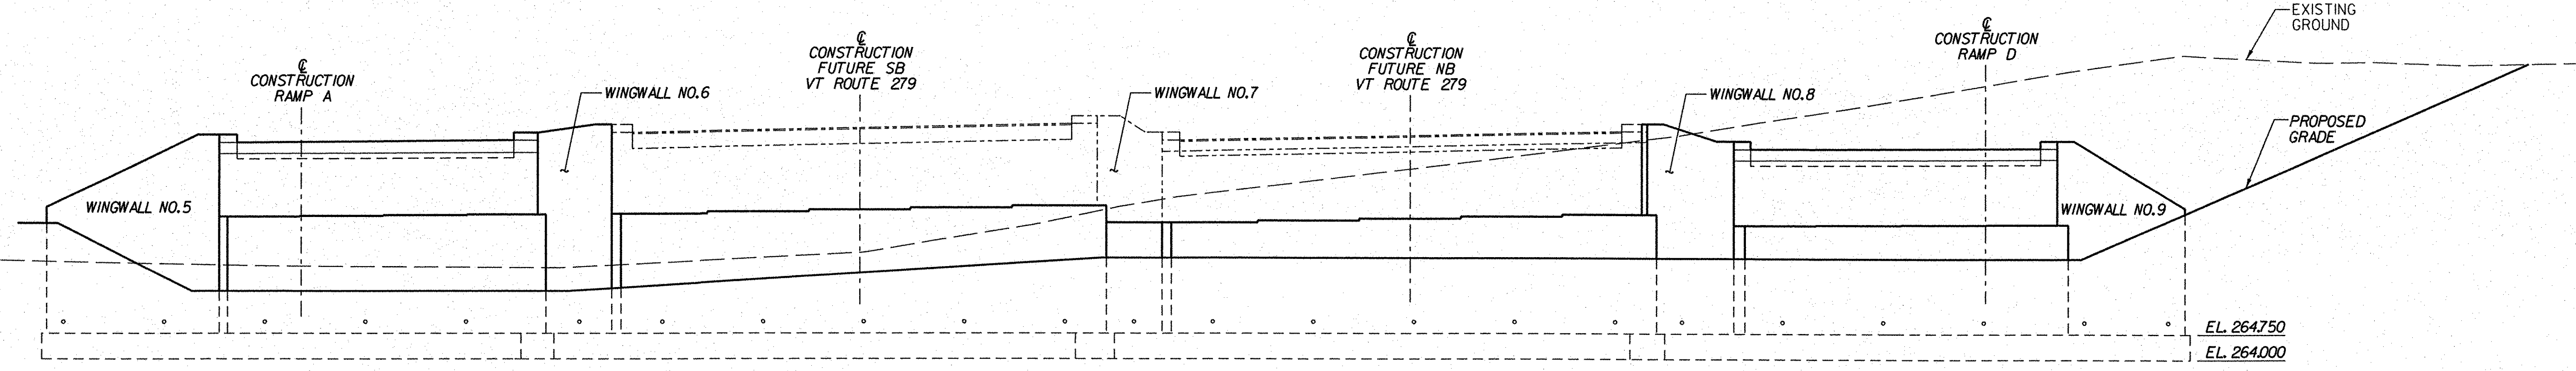

RAMP A


FUTURE SB VT ROUTE 279

FUTURE NB VT ROUTE 279

RAMP D

ELEVATION (LOOKING NORTH)
SCALE 1:100

LEGEND:
 FUTURE CONSTRUCTION (NOT CONSTRUCTED AS PART OF THIS CONTRACT)

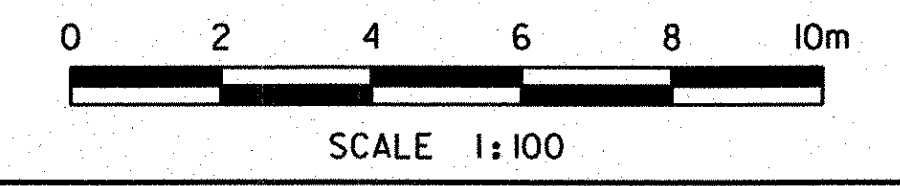

STATE OF VERMONT AGENCY OF TRANSPORTATION	
Town Of BENNINGTON	Bridge No. B15, B15N, B15S
Highway No. VT RTE 279	Log Sta. Surv. Sta.
VT ROUTE 279 & RAMPS OVER ROARING BRANCH OF WALLOOMSAC RIVER	
ABUTMENT 2 - PLAN AND ELEVATION	
Designed By M.D. BOWER	Drawn By D.S. URBINO
Checked By B.J. CARLSON	Date 06/08
K.M. WOJTKOWSKI Date 06/08	
PROJECT BENNINGTON	PROJECT NO. AC NH 019-1(51)
TVGA CAD Drawing No. AbutElev2.dgn	Date 02/02/2009
Bridge Sheet No. BR242	Sheet 229 of 367

