


FOOTING REINFORCEMENT PLAN


SCALE 1:50

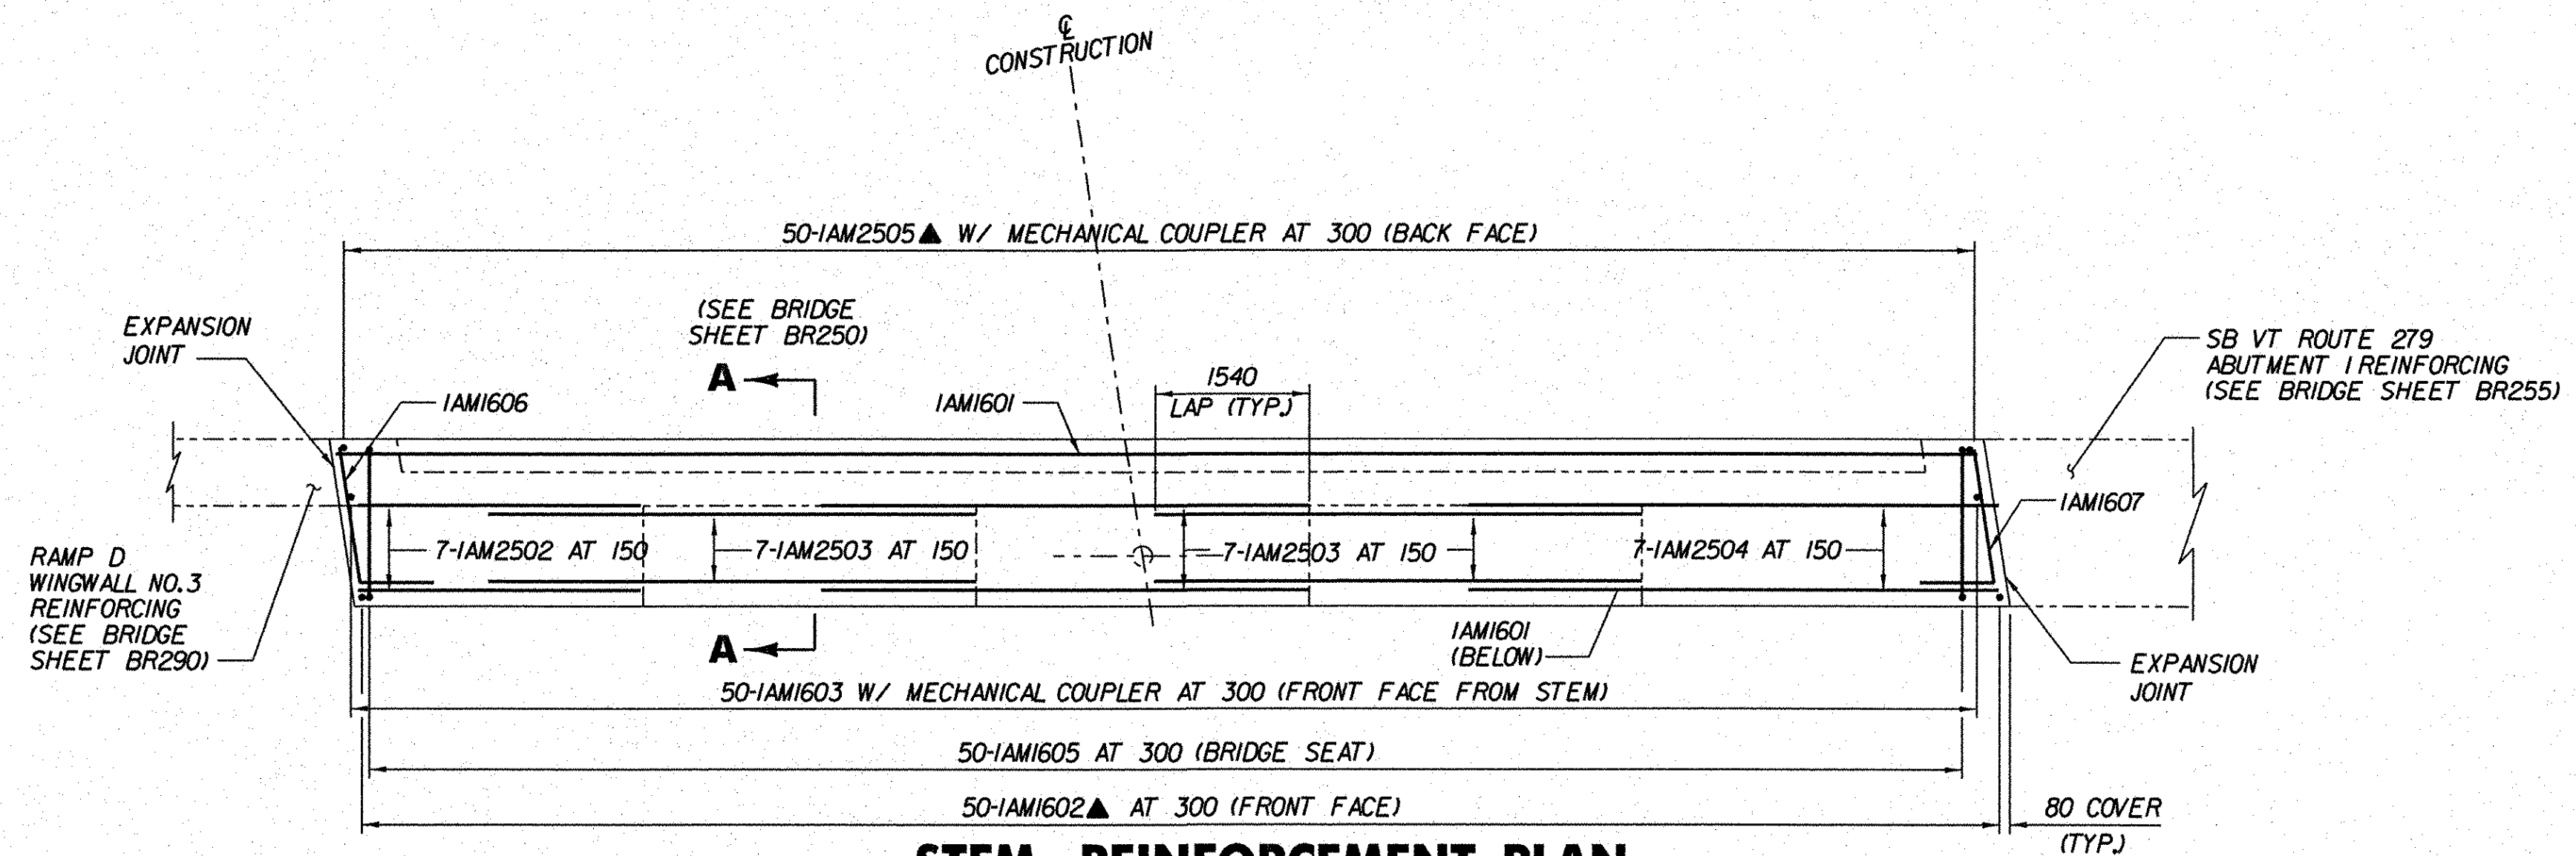

STEM REINFORCEMENT PLAN

SCALE 1:50

- LEGEND:**
- F.F. - FRONT FACE
 - B.F. - BACK FACE
 - E.F. - EACH FACE
 - C.B. - CORNER BAR
 - C.J. - CONSTRUCTION JOINT
 - ▲ - CUT TO FIT IN FIELD

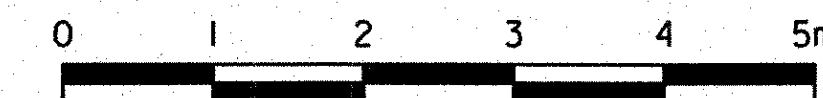

SCALE 1:50

**STATE OF VERMONT
AGENCY OF TRANSPORTATION**

Town Of	BENNINGTON	Bridge No.	BI5
Highway No.	VT RTE 279	Log Sta.	
		Surv. Sta.	

VT ROUTE 279 & RAMPS OVER ROARING BRANCH OF WALLOOMSAC RIVER

ABUTMENT 1 REINFORCEMENT PLANS (VT ROUTE 279)

Designed By	B.J. CARLSON	Drawn By	R.G. COCOL
-------------	--------------	----------	------------

Checked By	Date	Bridge Design Supervisor	Date
K.M. WOJTKOWSKI	06/08	K.M. WOJTKOWSKI	06/08

PROJECT	BENNINGTON	PROJECT NO.	AC NH 019-1(51)
---------	------------	-------------	-----------------

TVGA CAD Drawing No.	MainAReb.dgn	Date	02/02/2009
----------------------	--------------	------	------------

Bridge Sheet No.	BR249	Sheet	236 of 367
------------------	-------	-------	------------