


FOOTING REINFORCEMENT PLAN

SCALE 1:50

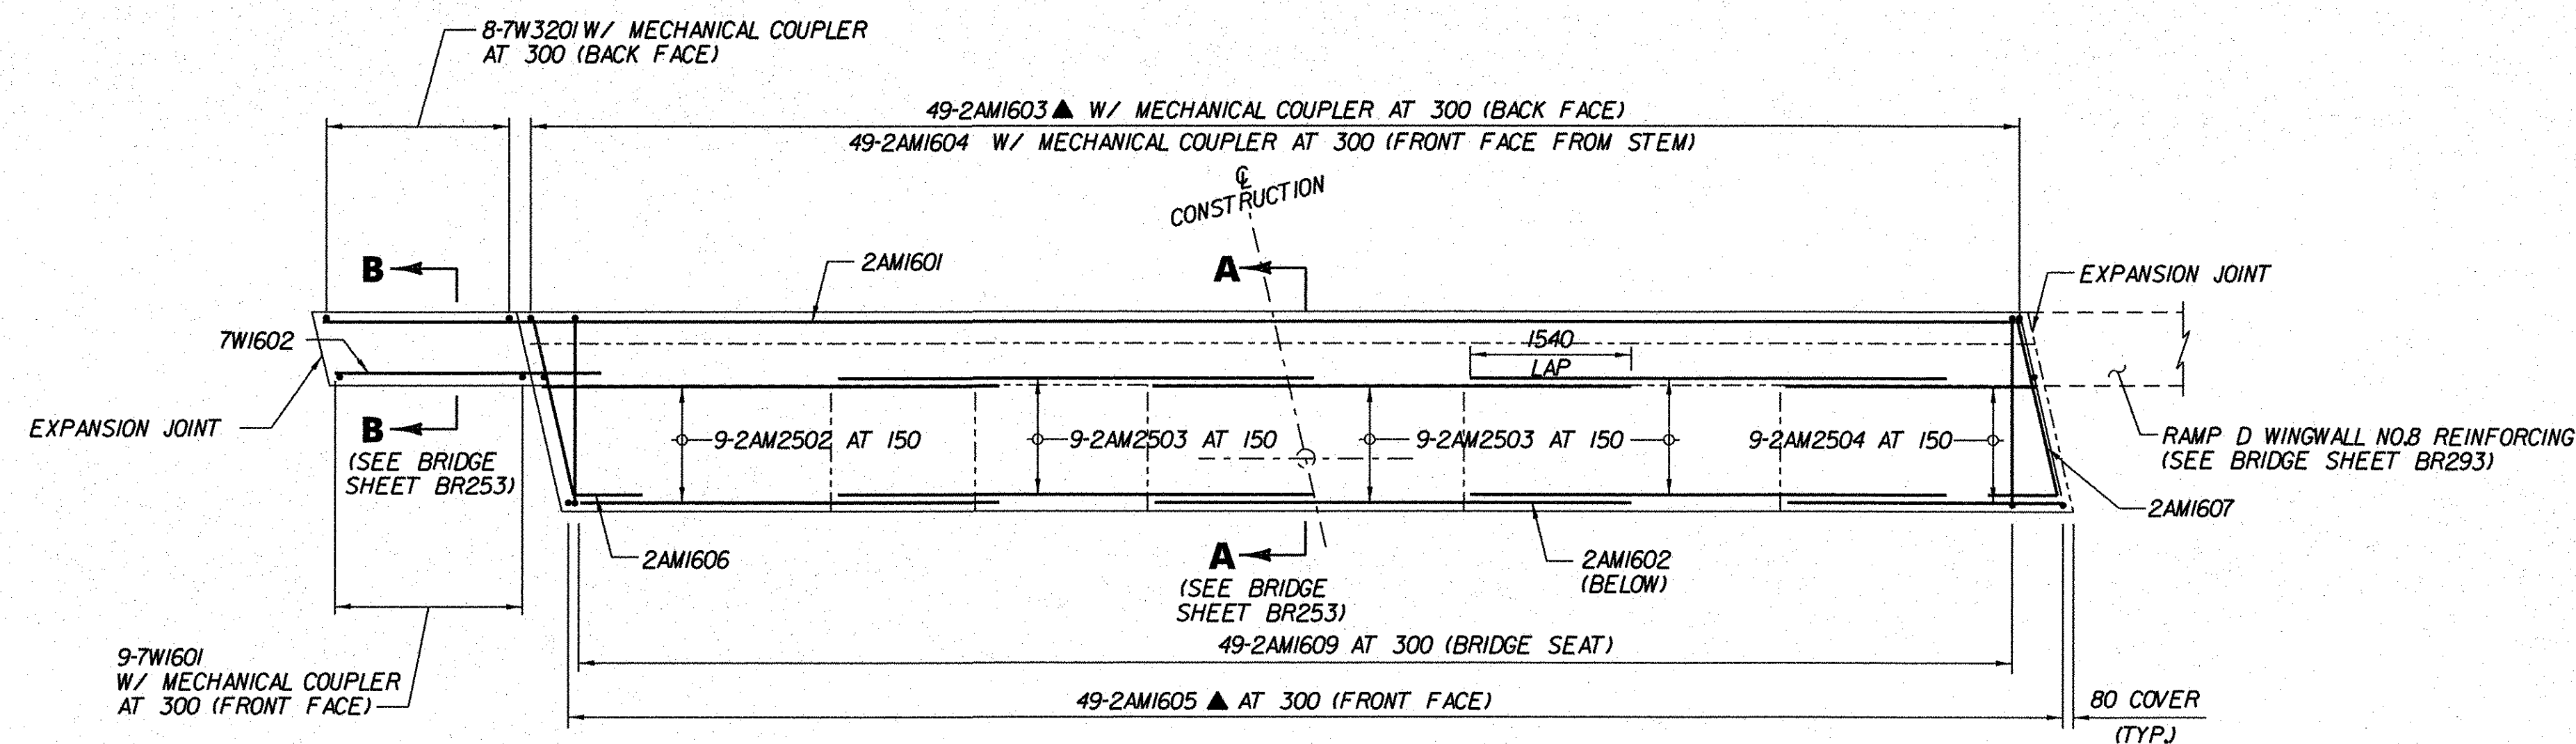


STEM REINFORCEMENT PLAN

SCALE 1:50

LEGEND:

- F.F. - FRONT FACE
- B.F. - BACK FACE
- E.F. - EACH FACE
- C.B. - CORNER BAR
- C.J. - CONSTRUCTION JOINT
- ▲ - CUT TO FIT IN FIELD

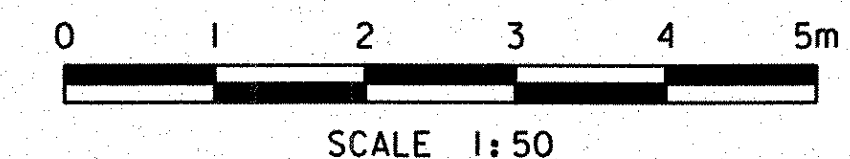

**STATE OF VERMONT
AGENCY OF TRANSPORTATION**

Town Of	BENNINGTON	Bridge No.	BI5
Highway No.	VT RTE 279	Log Sta.	
		Surv. Sta.	
VT ROUTE 279 & RAMPS OVER ROARING BRANCH OF WALLOOMSAC RIVER			
ABUTMENT 2 REINFORCEMENT PLANS (VT RTE 279)			
Designed By	B.J. CARLSON	Drawn By	R.G. COCOL
Checked By	K.M. WOJTKOWSKI	Date	06/08
		Bridge Design Supervisor	K.M. WOJTKOWSKI Date 06/08
PROJECT	BENNINGTON	PROJECT NO.	AC NH 019-1(51)
TVGA CAD Drawing No.	MainA2Reb.dgn	Date	02/02/2009
Bridge Sheet No.	BR252	Sheet	239 of 367