



FOOTING REINFORCEMENT PLAN
SCALE 1:50

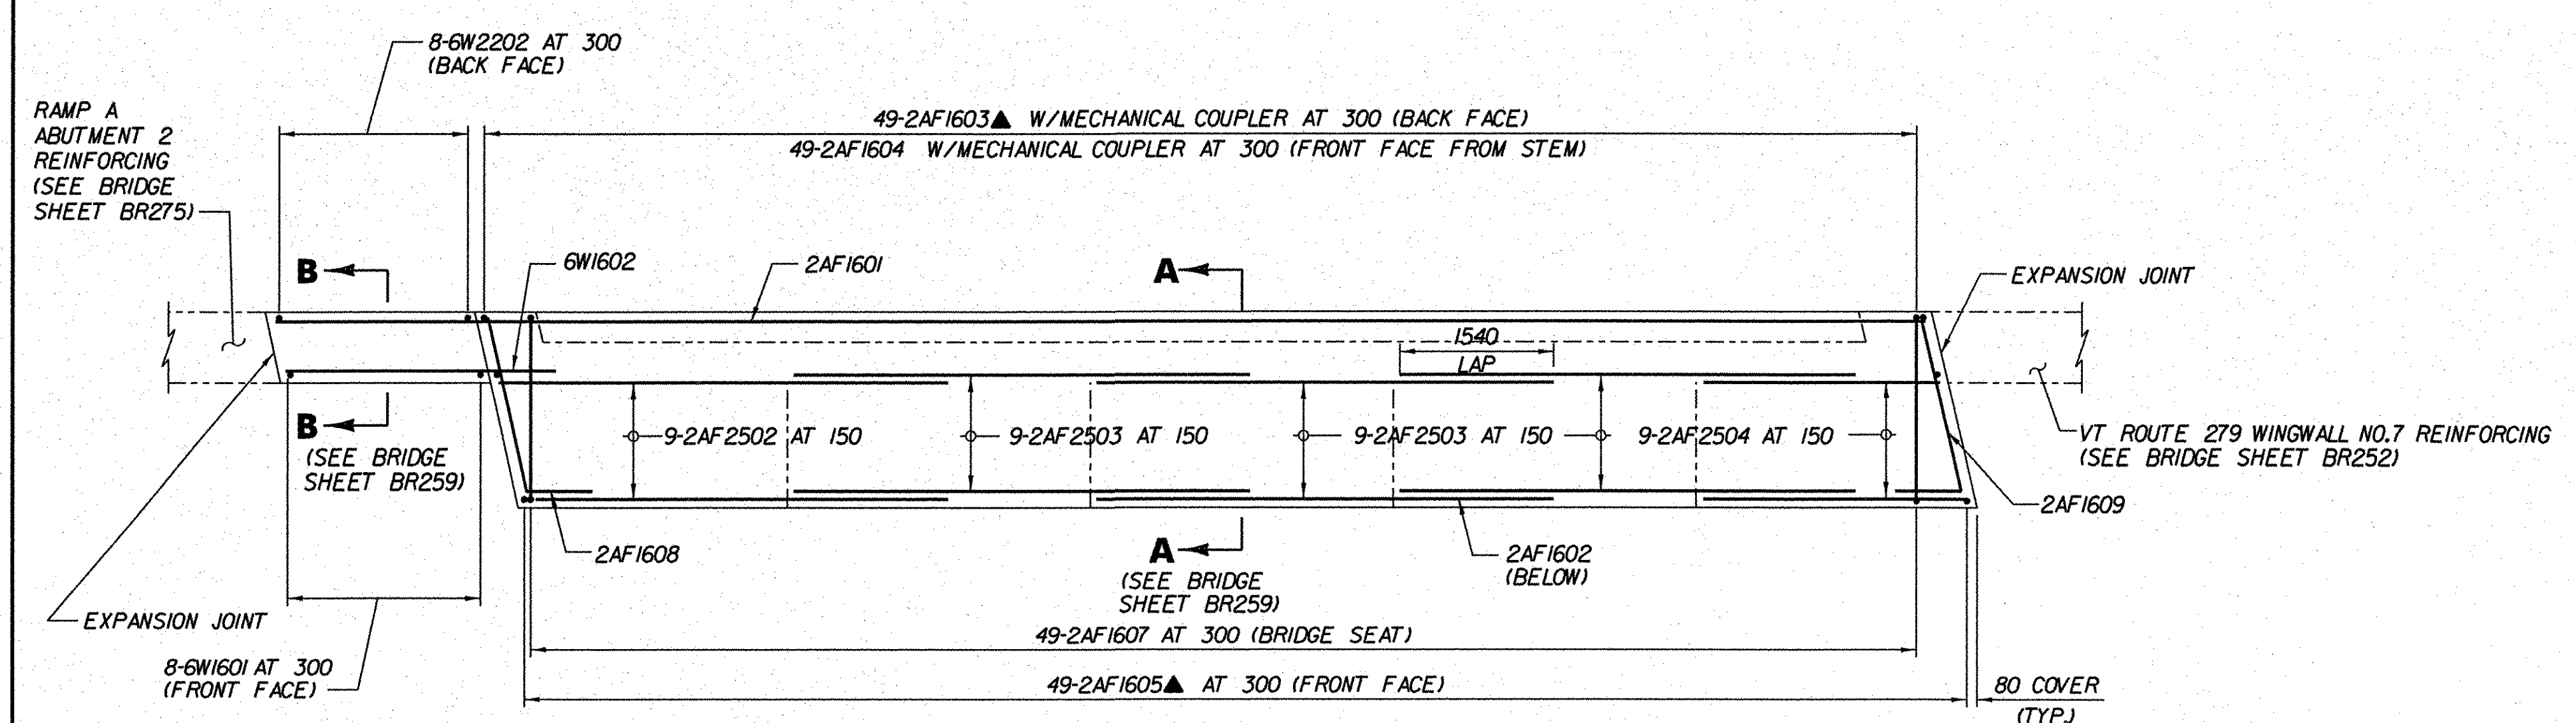

STEM REINFORCEMENT PLAN
SCALE 1:50

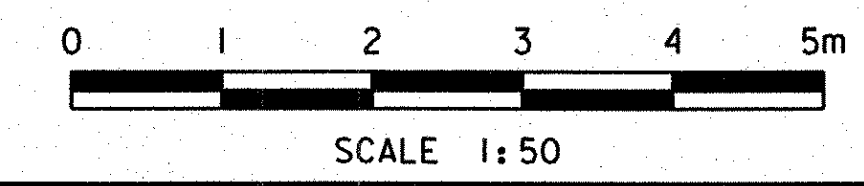

STATE OF VERMONT AGENCY OF TRANSPORTATION			
Town Of	BENNINGTON	Bridge No.	BI5
Highway No.	VT RTE 279	Log Sta.	
		Surv. Sta.	
VT ROUTE 279 & RAMPS OVER ROARING BRANCH OF WALLOOMSAC RIVER			
ABUTMENT 2 REINFORCEMENT (SB VT ROUTE 279)			
Designed By	B.J. CARLSON	Drawn By	D.W. SHAFFER
Checked By	Date	Bridge Design Supervisor	
K.M. WOJTKOWSKI	05/08	K.M. WOJTKOWSKI	Date 05/08
PROJECT	PROJECT NO.		
BENNINGTON	AC NH 019-1(51)		
TVGA CAD Drawing No. SBA2Reb.dgn	Date	02/02/2009	
Bridge Sheet No. BR258	Sheet	245 of 367	

