


RAILING LAYOUT PLAN

SCALE 1:125

* RAIL EXPANSION JOINT OR SPLICE SHALL BE LOCATED 610 FROM CENTERLINE OF INDICATED POST, ON BRIDGE EXPANSION JOINT (ABUTMENT) SIDE OF POST.

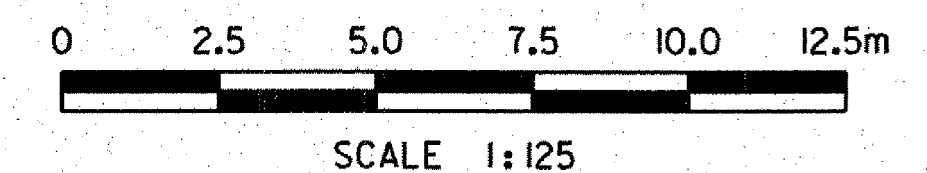

NOTES:

- FOR NETC 2-RAIL BRIDGE RAILING DETAILS AND INFORMATION ABOUT THE NETC GUARD RAIL APPROACH SECTION, SEE BRIDGE SHEET BR310 THROUGH BRIDGE SHEET BR313.
- ITEM 616.28 "CAST-IN-PLACE CONCRETE CURB, TYPE B" SHALL BE PLACED ADJACENT TO EACH APPROACH SLAB QUADRANT. SEE GUARD RAIL APPROACH SECTION, NETC 2 RAIL, BRIDGE SHEET BR311 AND BRIDGE SHEET BR312 FOR DETAILS.

TVGA
CONSULTANTS

**STATE OF VERMONT
AGENCY OF TRANSPORTATION**

Town Of	BENNINGTON	Bridge No.	BI55
Highway No.	VT RTE 279	Log Sta.	
		Surv. Sta.	
VT ROUTE 279 & RAMPS OVER ROARING BRANCH OF WALLOOMSAC RIVER			
RAILING LAYOUT (RAMP A)			
Designed By	J.T. DEPLANCHE	Drawn By	D.S. URBINO
Checked By	Date	Bridge Design Supervisor	
B.J. CARLSON	05/08	K.M. WOJTKOWSKI Date 05/08	
PROJECT	BENNINGTON	PROJECT NO. AC NH 019-1(51)	
TVGA CAD Drawing No.	RmpARail.dgn	Date 02/02/2009	
Bridge Sheet No.	BR263	Sheet 250 of 367	