




**LAYOUT DIGRAM**  
1:125

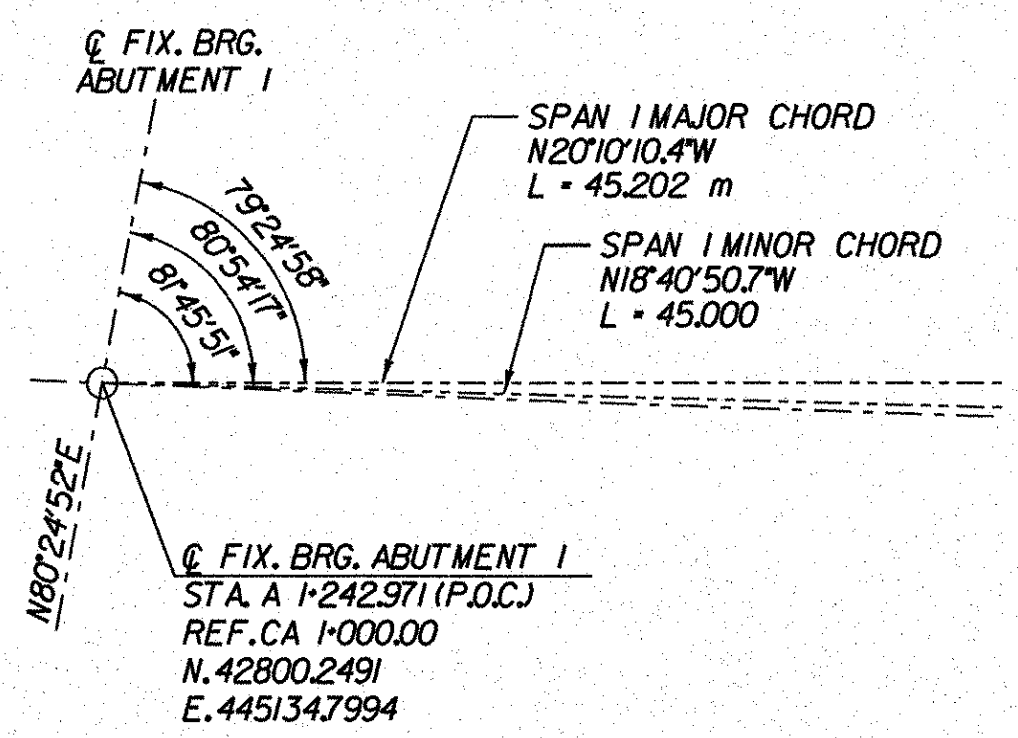


**ABUTMENT 1**  
NOT TO SCALE

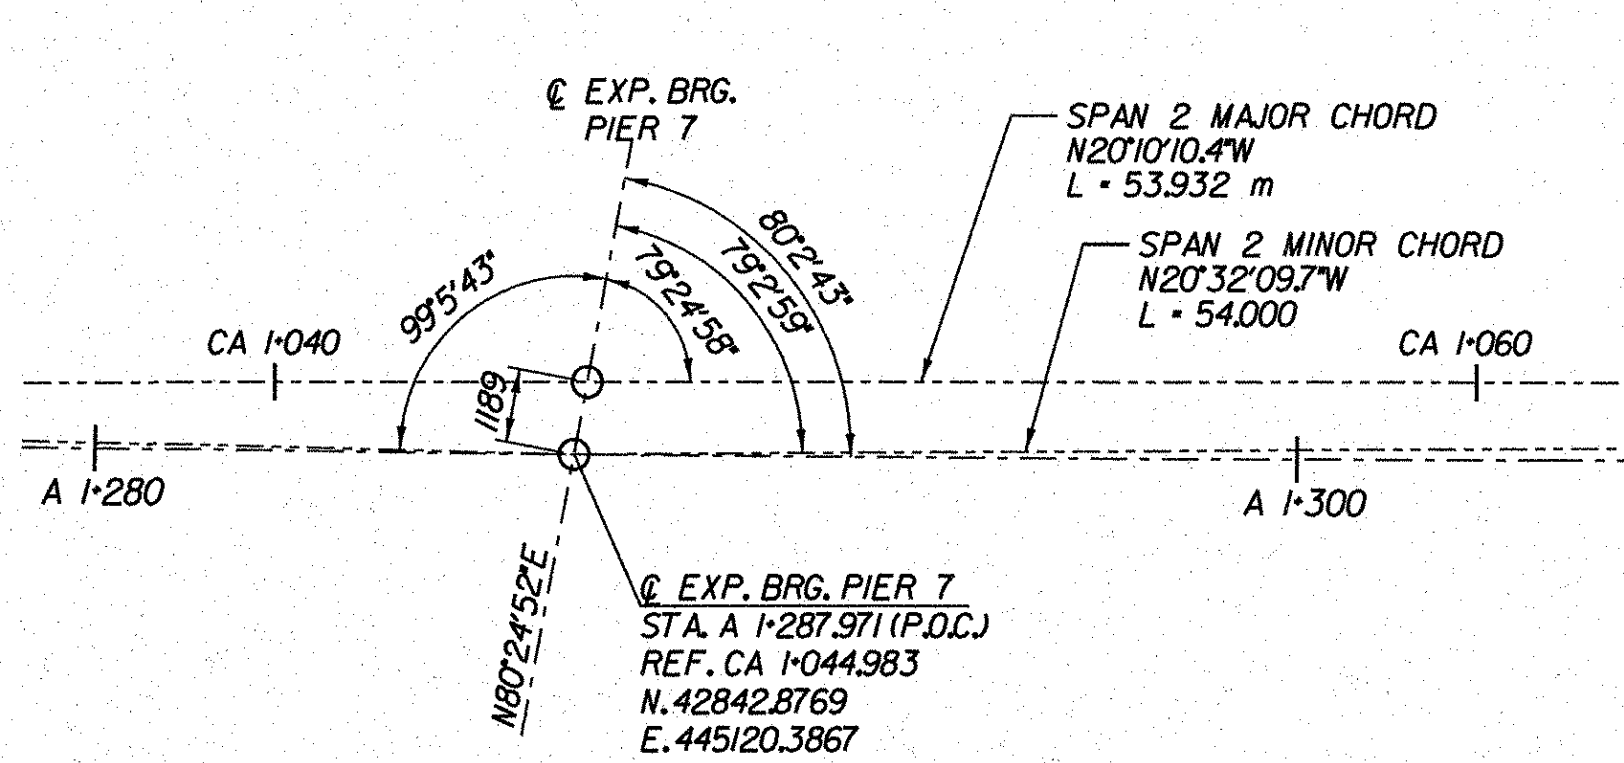

**PIER 7**  
NOT TO SCALE

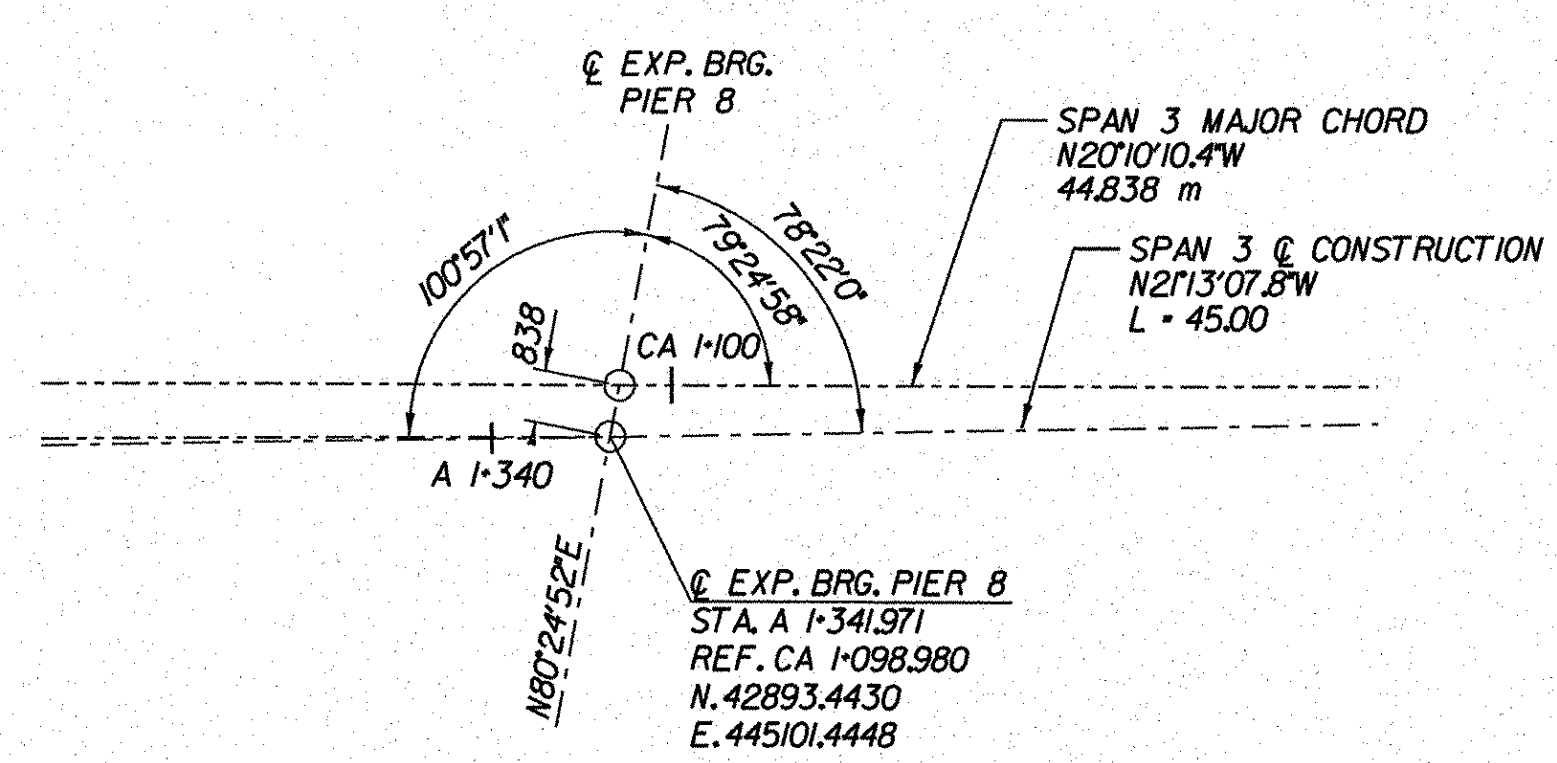

**PIER 8**  
NOT TO SCALE

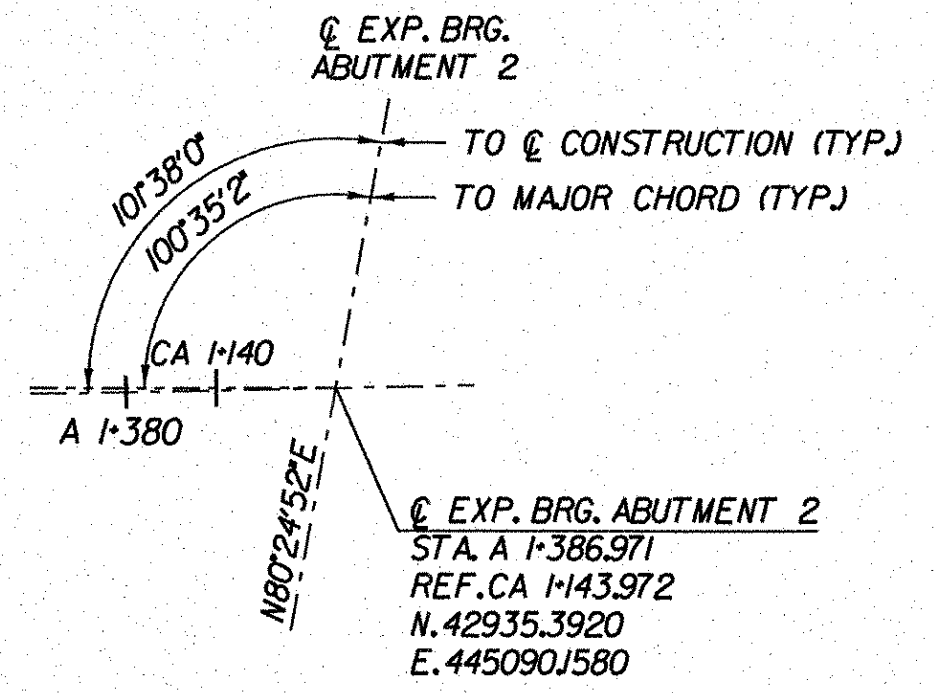

**ABUTMENT 2**  
NOT TO SCALE

**NOTES:**

- 1. WORK THIS SHEET WITH FRAMING PLAN (SHEET 1 OF 2) (RAMP A), BRIDGE SHEET BR264.

**STATE OF VERMONT  
AGENCY OF TRANSPORTATION**

Town Of	BENNINGTON	Bridge No.	B155
Highway No.	VT 279	Log Sta.	
		Surv. Sta.	
VT ROUTE 279 & RAMPS OVER ROARING BRANCH OF WALLOOSAC RIVER			
<b>FRAMING PLAN (SHEET 2 OF 2) (RAMP A)</b>			
Designed By	J.J. MANUSE	Drawn By	D.S. URBINO
Checked By	B.J. CARLSON	Date	04/08
		Bridge Design Supervisor	K.M. WOJTKOWSKI
		Date	04/08
PROJECT	BENNINGTON	PROJECT NO.	AC NH 019-1(51)
TVGA CAD Drawing No.	RmpAFrm2.dgn	Date	02/02/2009
Bridge Sheet No.	BR265	Sheet	252 of 367

