



CROSS SECTION INFORMATION FOR A 1+080 - A 1+563.423 SHOWN ON RAMP D SECTIONS

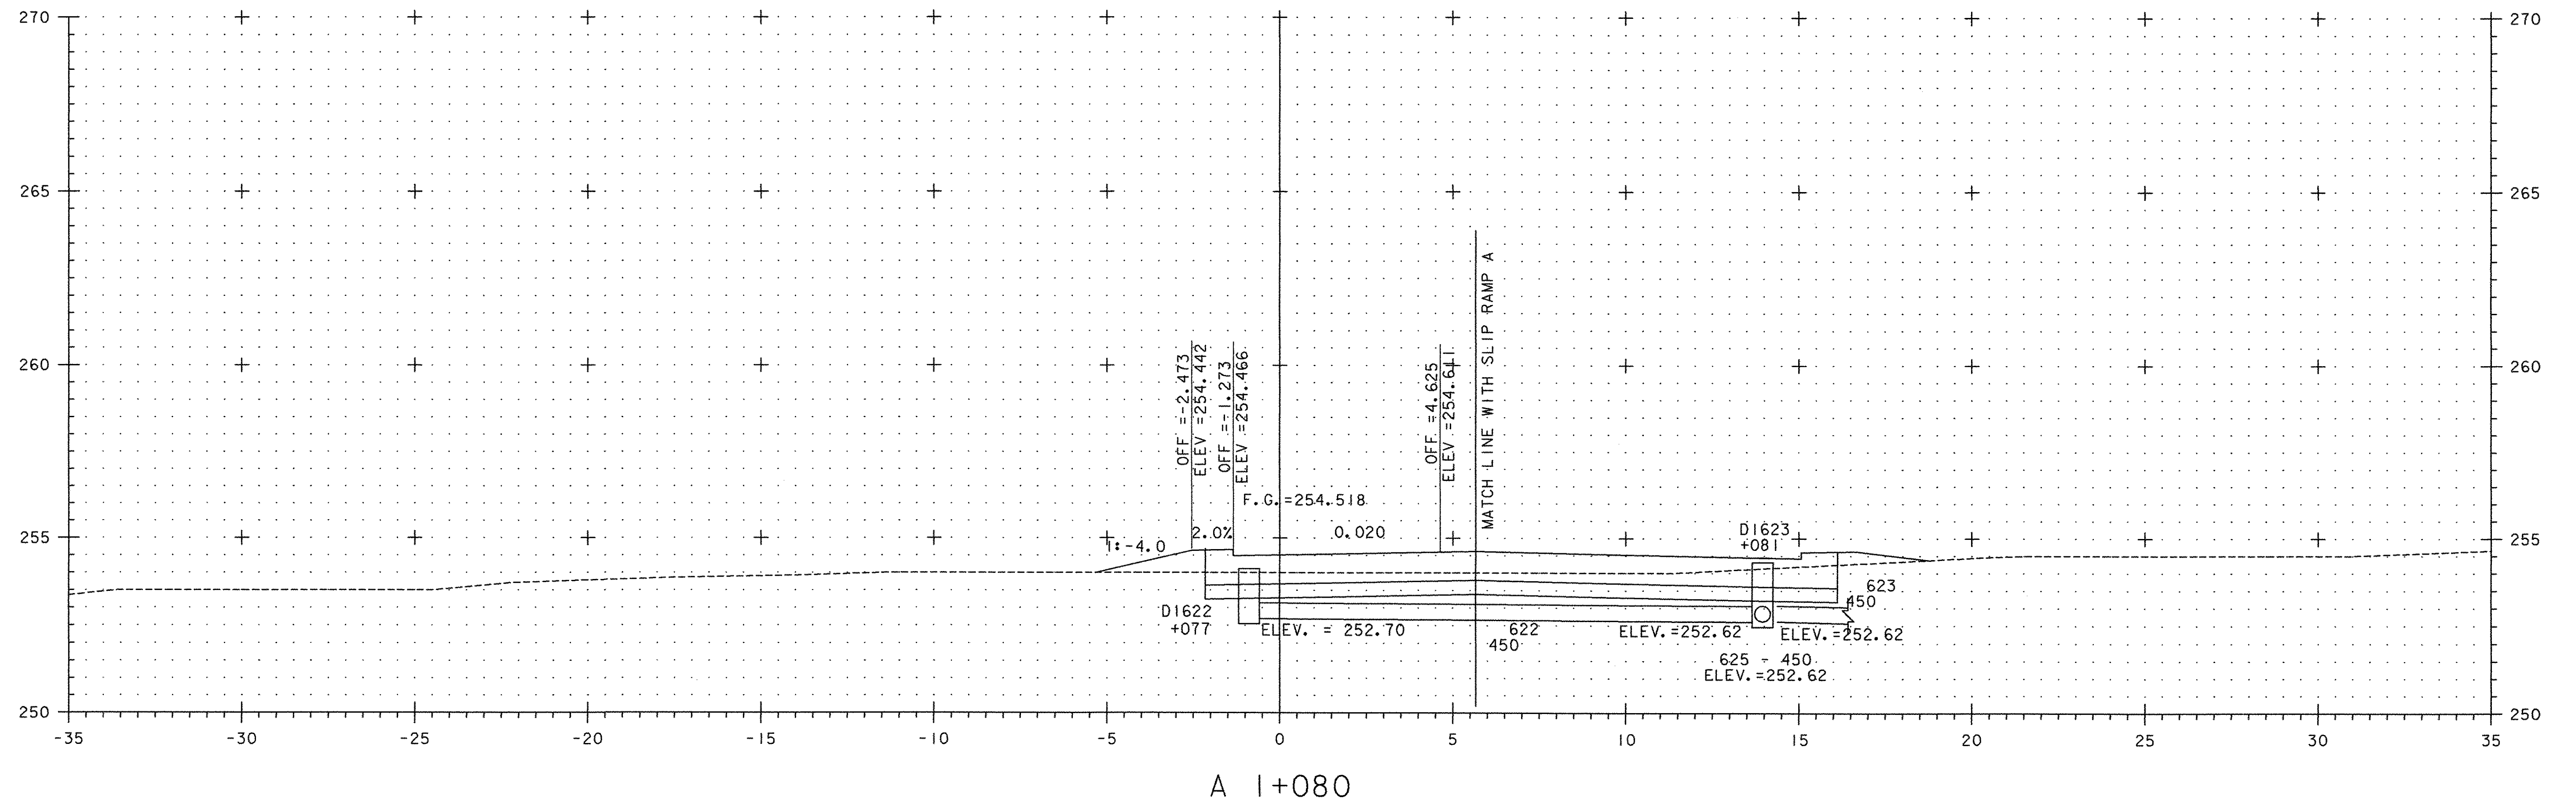

W:\953\active\9530002\transportation\drawing\center\det\_1\plot\_files\zd307cxls\_rampa.pxf

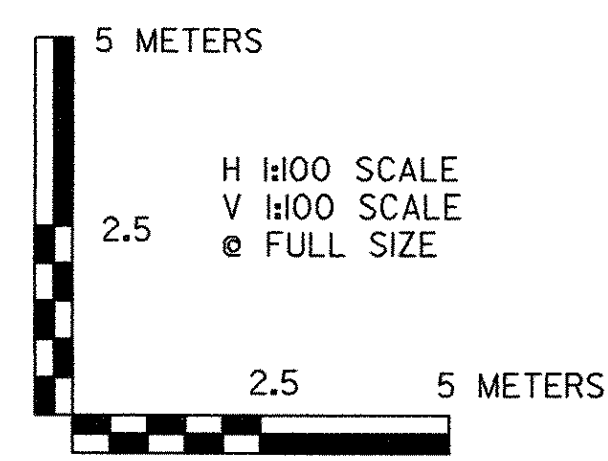

<b>VERMONT AGENCY OF TRANSPORTATION</b>	
	PROJECT NAME: BENNINGTON PROJECT NUMBER: AC NH 019-1(51)
	FILE NAME: ...plot_files\zd307cxls_rampa.pxf PLOT DATE: 1/29/2009 DESIGN SUPERVISOR: GREG EDWARDS DRAWN BY: STANTEC DESIGNED BY: MARC FOISY CHECKED BY: GARY SANTY <b>RAMP A CROSS SECTIONS AX-02</b> SHEET 320 OF 367