

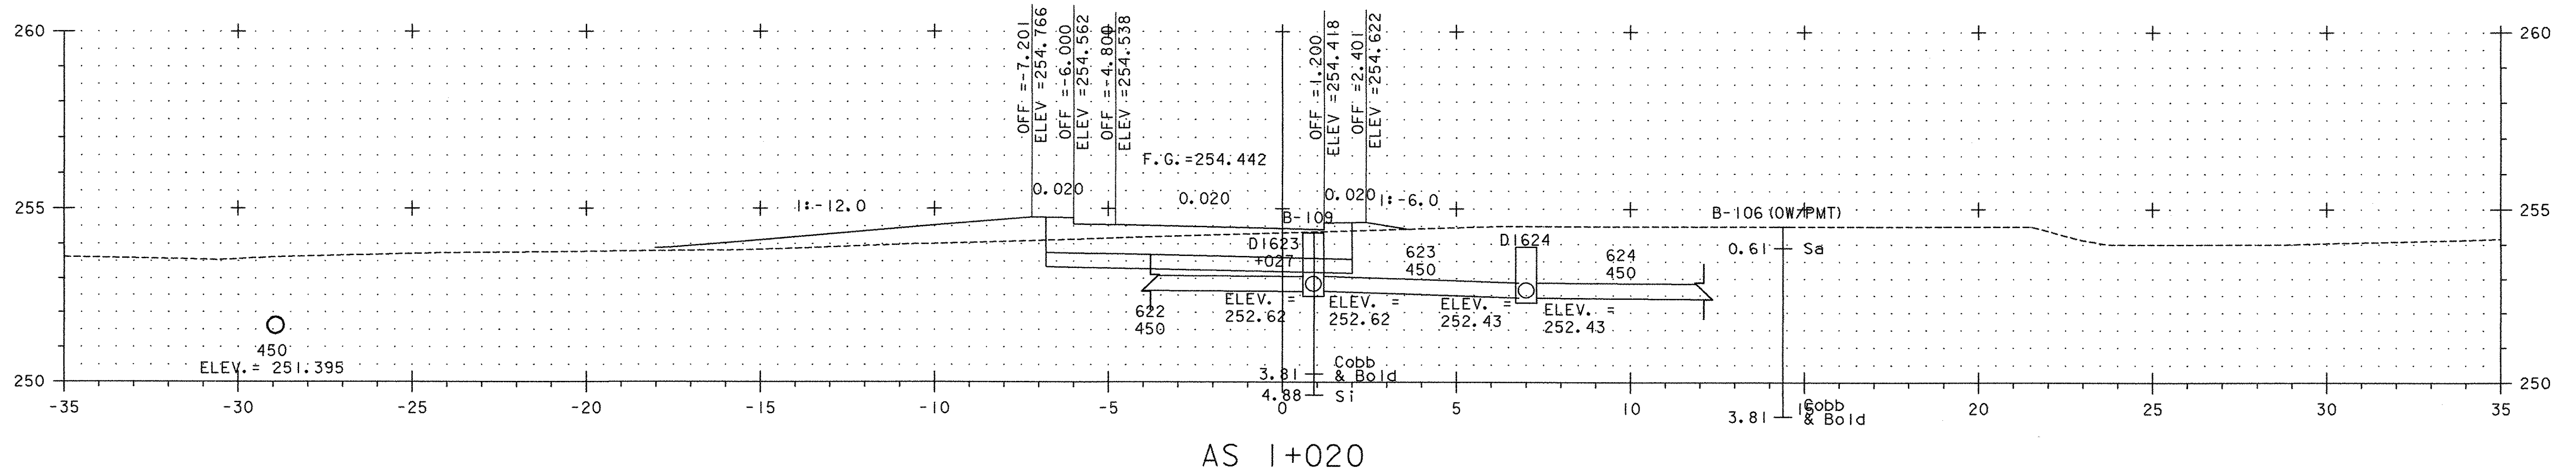


AS 1+046.836 = A 1+095.046, 7.2m RT.

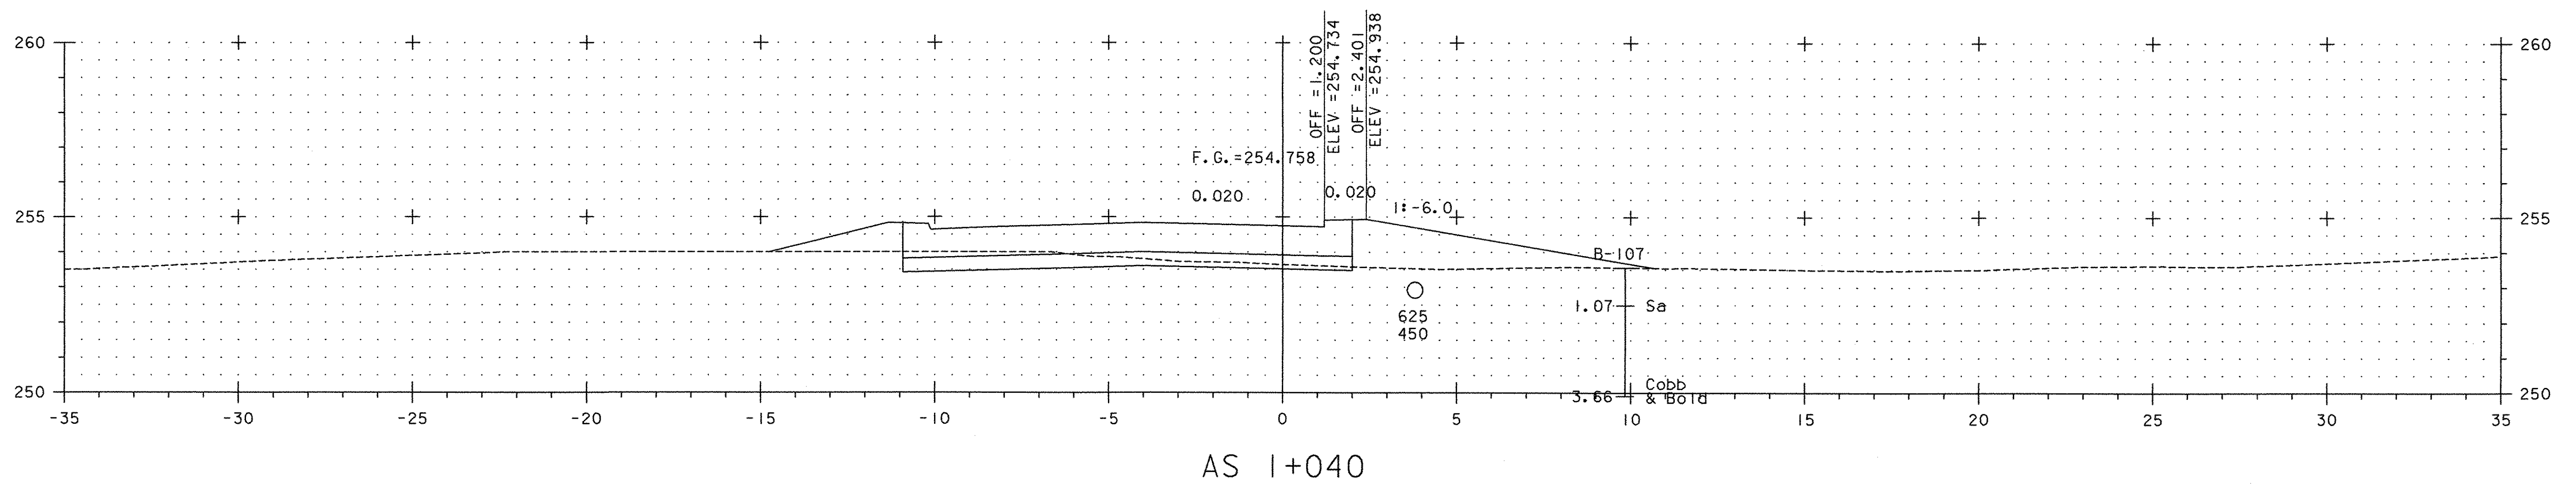

AS 1+000.000 = VT 1+438.235, 10.579m LT.

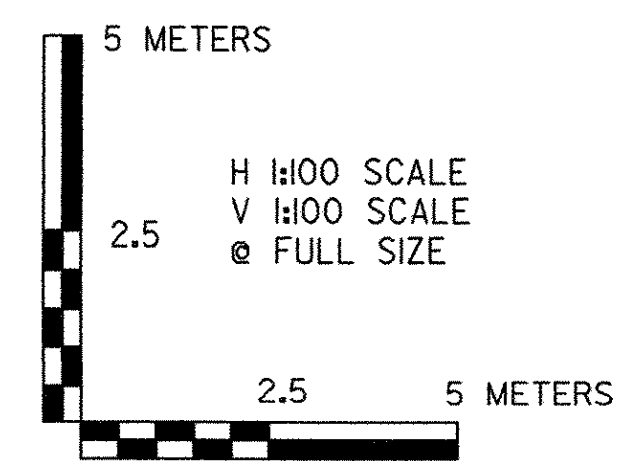

VERMONT AGENCY OF TRANSPORTATION		
	PROJECT NAME: BENNINGTON	PLOT DATE: 1/29/2009
	PROJECT NUMBER: AC NH 019-(K51)	DRAWN BY: STANTEC
DESIGN SUPERVISOR: GREG EDWARDS	DESIGNED BY: MARC FOISY	CHECKED BY: GARY SANTY
SLIP RAMP A CROSS SECTIONS ASX-01		SHEET 321 OF 367

V:\053\acfive\0530002\transportation\drawing\contract\plot_files\z3d3070ks.asptff