
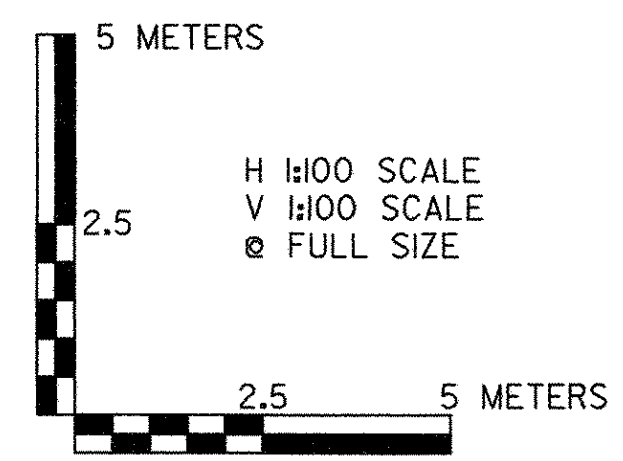



STA. D I+000.000 = VT I+540.000, 4.950 m LT.

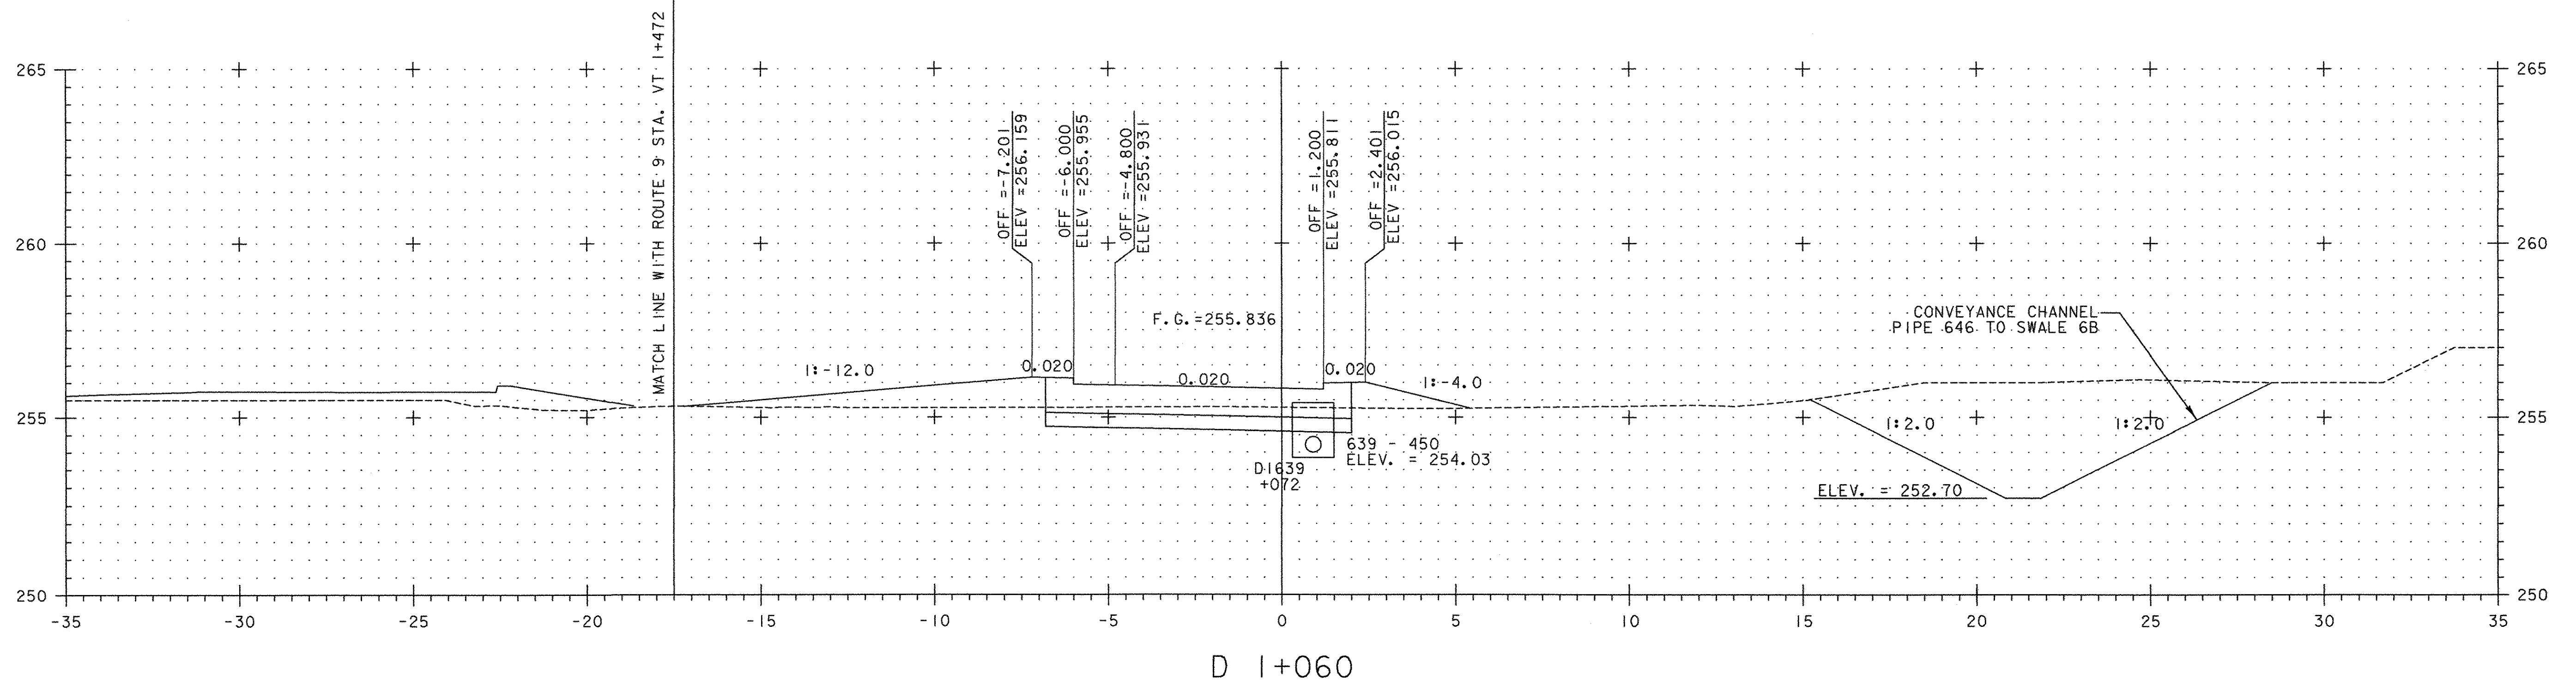

| | |
|---|---------------------------------|
| VERMONT AGENCY OF TRANSPORTATION | |
|  Stantec | PROJECT NAME: BENNINGTON |
| | PROJECT NUMBER: AC NH 019-(K51) |
| FILE NAME: ...vd307clxs_combined.ptf | PLOT DATE: 2/2/2009 |
| DESIGN SUPERVISOR: GREG EDWARDS | DRAWN BY: STANTEC |
| DESIGNED BY: MARC FOISY | CHECKED BY: GARY SANTY |
| RAMP D CROSS SECTIONS DX-01 | SHEET 322 OF 367 |

V:\1953\active\1953\0002\transportation\drawing\contract\plot_files\z4307clxs_combined.ptf