


D 1+080

v:\953\active\9530002\transportation\drawing\contract\plot\_files\z4307ciks\_combined.dxf

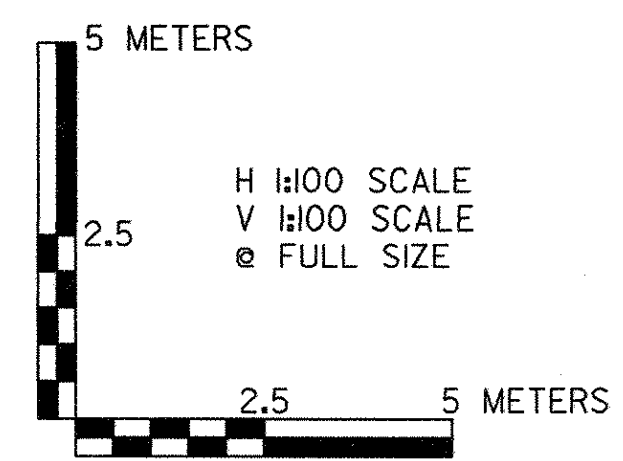

<b>VERMONT AGENCY OF TRANSPORTATION</b>	
	PROJECT NAME: BENNINGTON
	PROJECT NUMBER: AC NH 019-(51)
FILE NAME: ...z4307ciks_combined.dxf	PLOT DATE: 2/2/2009
DESIGN SUPERVISOR: GREG EDWARDS	DRAWN BY: STANTEC
DESIGNED BY: MARC FOISY	CHECKED BY: GARY SANTY
<b>RAMP D CROSS SECTIONS DX-02</b>	
SHEET 323 OF 367	