



D 1+140.000 = A 1+141.720

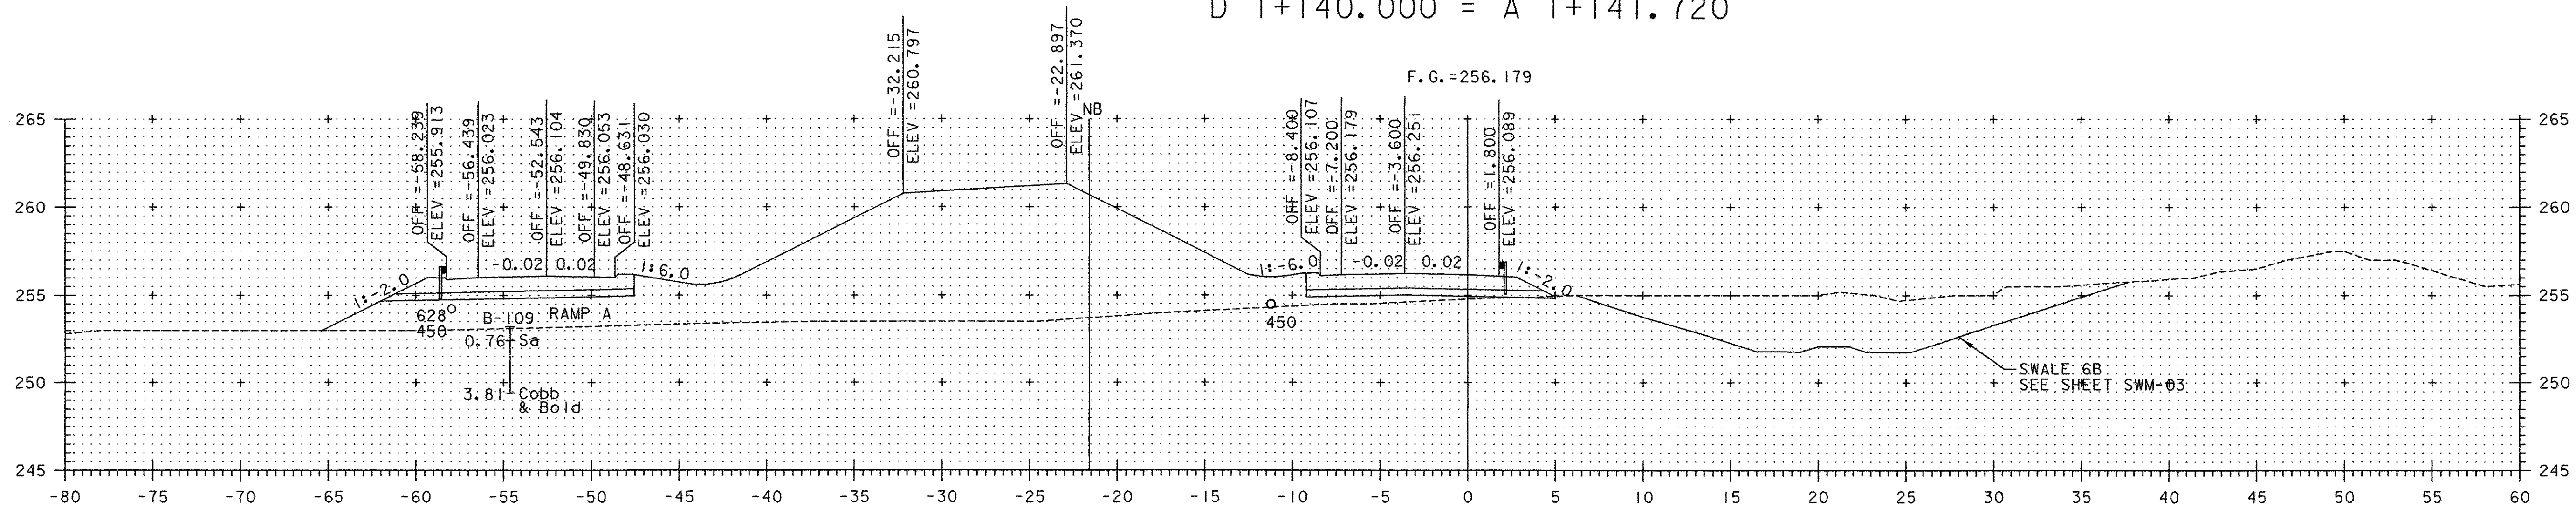


D 1+120.000 = A 1+121.716

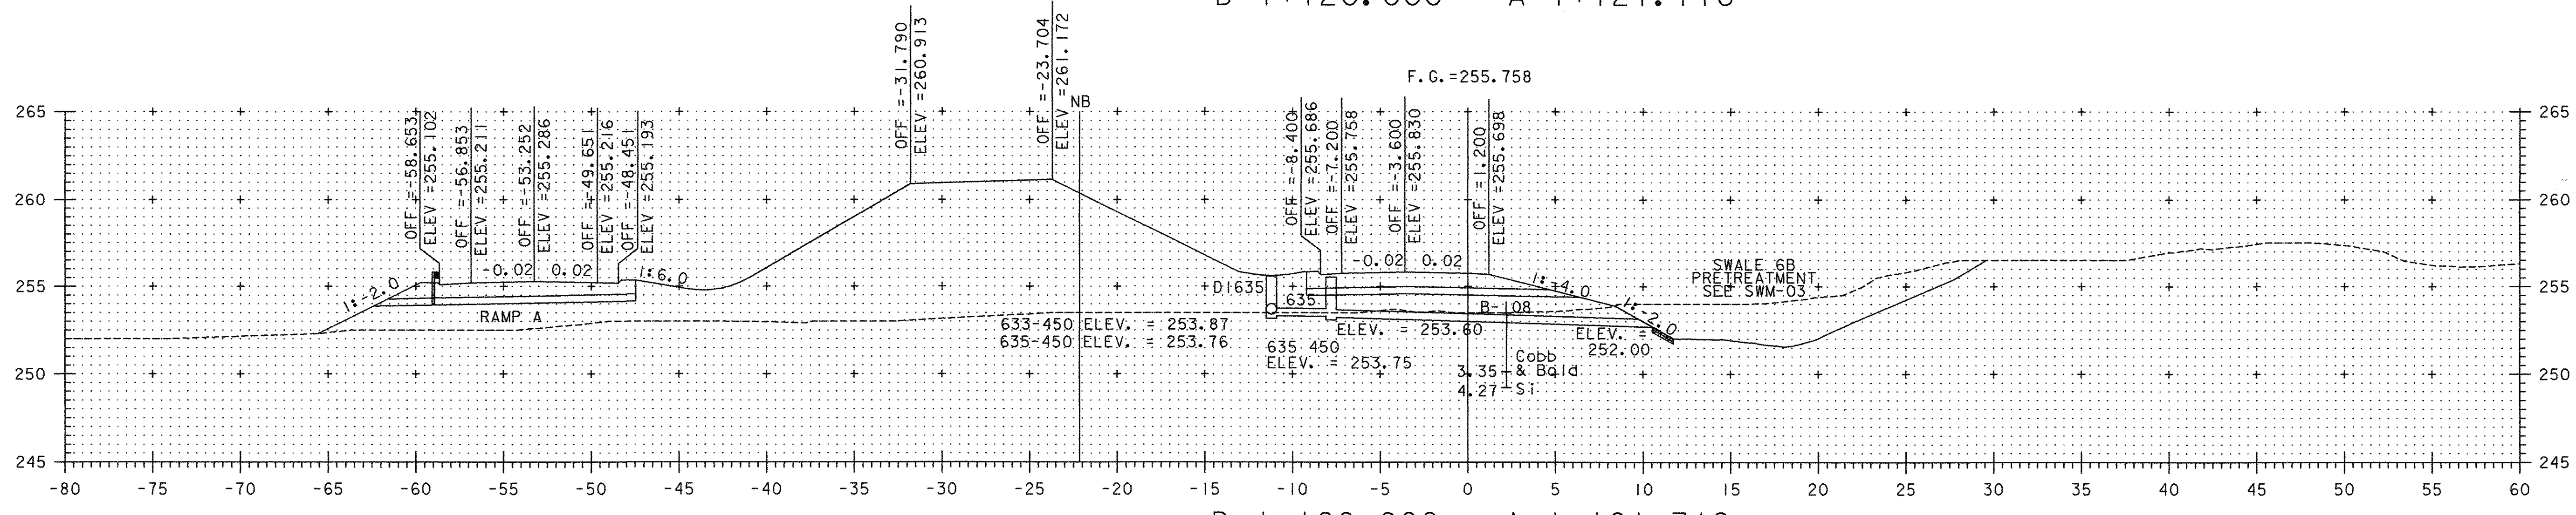

D 1+100.000 = A 1+101.712

NOTE:  
FOR CLARITY, RAMP A CROSS SECTIONS HAVE BEEN COMBINED WITH RAMP D CROSS SECTIONS. BE ADVISED RAMP A SECTIONS ARE PERPENDICULAR TO RAMP D ALIGNMENT. ALL OFFSETS SHOWN ARE FROM RAMP D.

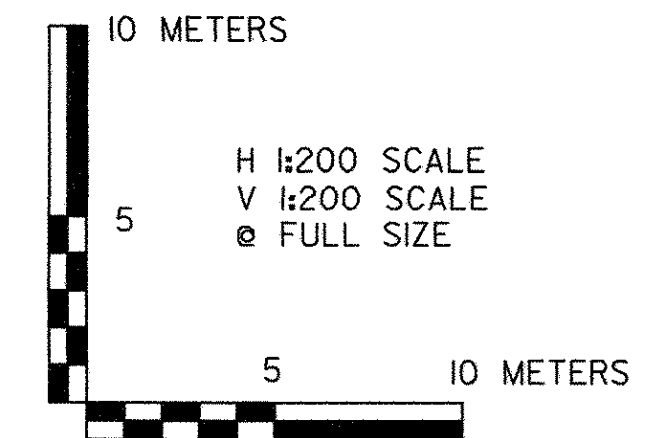

**VERMONT AGENCY OF TRANSPORTATION**

PROJECT NAME: BENNINGTON  
PROJECT NUMBER: AC NH 019-(K51)

FILE NAME: ...vzd307cixs\_combined.ptf PLOT DATE: 2/2/2009  
DESIGN SUPERVISOR: GREG EDWARDS DRAWN BY: STANTEC  
DESIGNED BY: MARC FOISY CHECKED BY: GARY SANTY  
**RAMP D CROSS SECTIONS DX-03** SHEET 324 OF 367

V:\NBS\active\NBS310002\transportation\drawing\contract\_1\plot\_files\z307cixs\_combined.plt