



D 1+180.000 = A 1+181.027

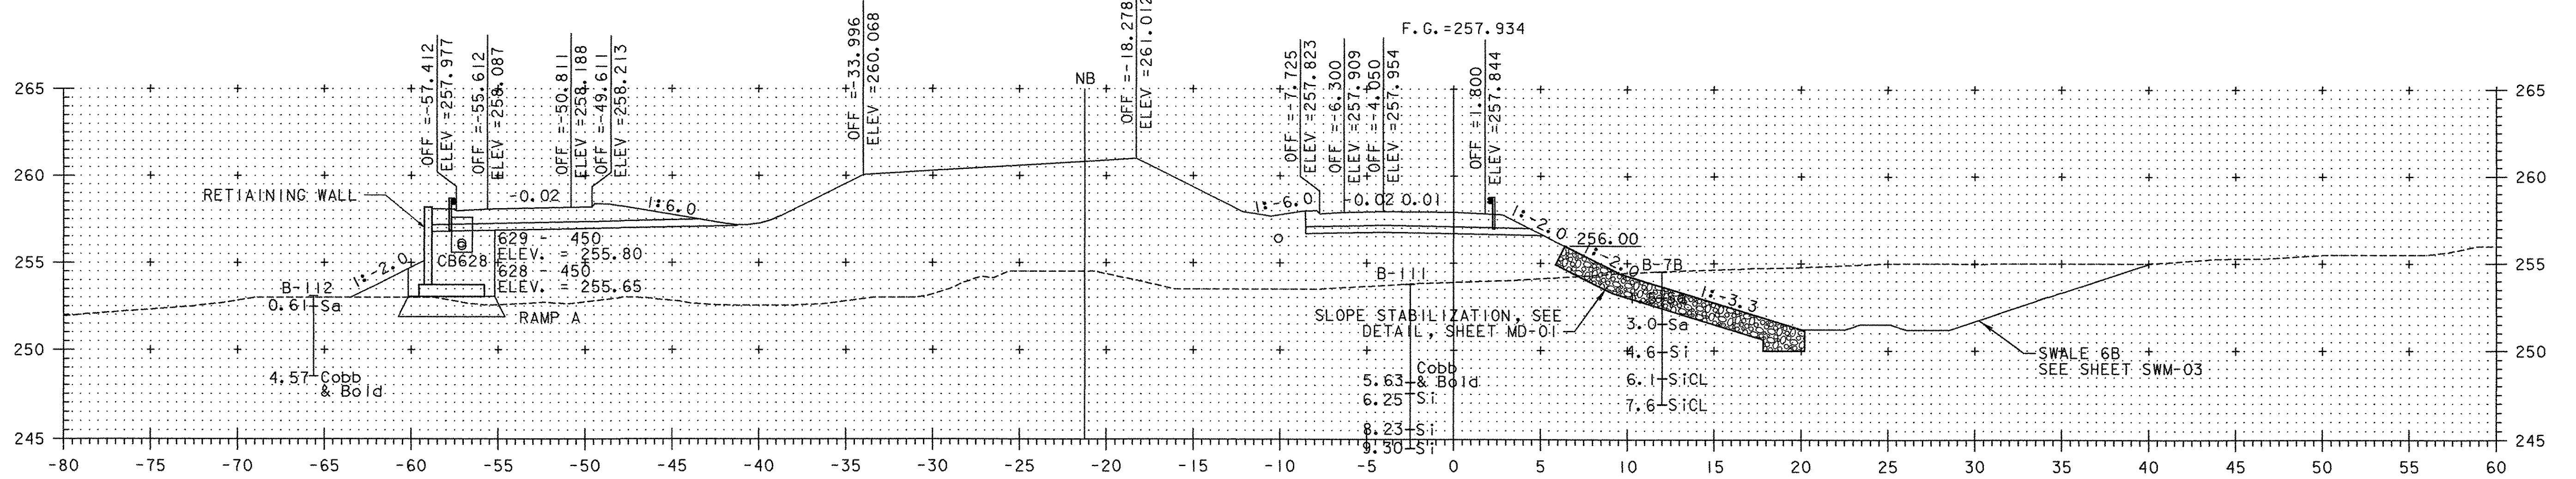

D 1+160.000 = A 1+161.724

NOTE:  
 FOR CLARITY, RAMP A CROSS SECTIONS HAVE BEEN  
 COMBINED WITH RAMP D CROSS SECTIONS. BE ADVISED  
 RAMP A SECTIONS ARE PERPENDICULAR TO RAMP D  
 ALIGNMENT. ALL OFFSETS SHOWN ARE FROM RAMP D.

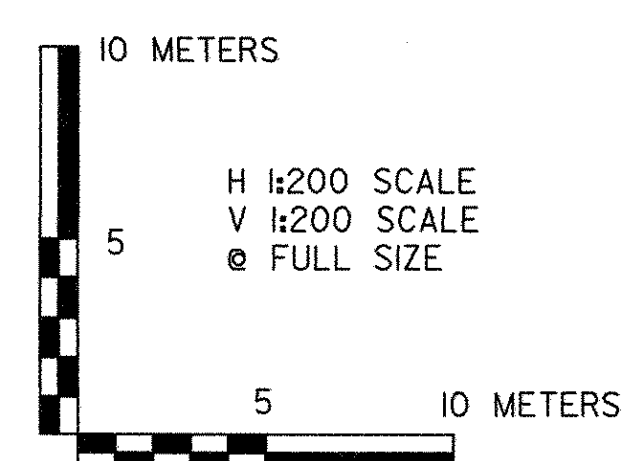

VERMONT AGENCY OF TRANSPORTATION



PROJECT NAME: BENNINGTON  
 PROJECT NUMBER: AC NH 019-1(51)  
 FILE NAME: ...z307cixs\_combined.ptf PLOT DATE: 2/2/2009  
 DESIGN SUPERVISOR: GREG EDWARDS DRAWN BY: STANTEC  
 DESIGNED BY: MARC FOISY CHECKED BY: GARY SANTY  
**RAMP D CROSS SECTIONS DX-04** SHEET 325 OF 367

v:\9551\ve\9551002\transportation\drawing\constr\oct\_1\plot\_files\z307cixs\_combined.plt