


NOTE:
FOR CLARITY, RAMP A CROSS SECTIONS HAVE BEEN
COMBINED WITH RAMP D CROSS SECTIONS. BE ADVISED
RAMP A SECTIONS ARE PERPENDICULAR TO RAMP D
ALIGNMENT. ALL OFFSETS SHOWN ARE FROM RAMP D.



VERMONT AGENCY OF TRANSPORTATION

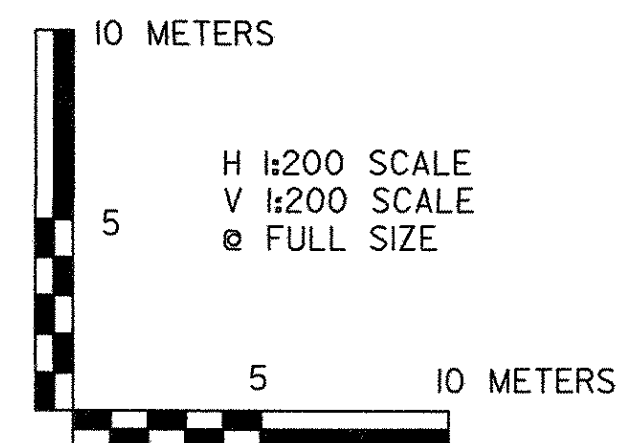

PROJECT NAME: BENNINGTON
PROJECT NUMBER: AC NH 019-1(51)

FILE NAME: ...z307c1xs.combined.ptf
DESIGN SUPERVISOR: GREG EDWARDS
DESIGNED BY: MARC FOISY

PLOT DATE: 2/2/2009
DRAWN BY: STANTEC
CHECKED BY: GARY SANTY
SHEET 326 OF 367

RAMP D CROSS SECTIONS DX-05

V:\BES\active\19531002\transportation\drawing\constr\sect_n\plot_files\z307c1xs.combined.ptf