


NOTE:
 FOR CLARITY, RAMP A CROSS SECTIONS HAVE BEEN
 COMBINED WITH RAMP D CROSS SECTIONS. BE ADVISED
 RAMP A SECTIONS ARE PERPENDICULAR TO RAMP D
 ALIGNMENT. ALL OFFSETS SHOWN ARE FROM RAMP D.



VERMONT AGENCY OF TRANSPORTATION

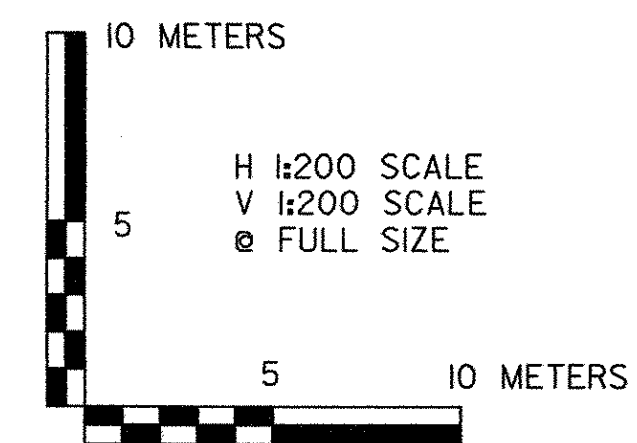

PROJECT NAME: BENNINGTON
 PROJECT NUMBER: AC NH 019-1(51)
 FILE NAME: ...z307c1xs_combined.prf PLOT DATE: 1/29/2009
 DESIGN SUPERVISOR: GREG EDWARDS DRAWN BY: STANTEC
 DESIGNED BY: MARC FOISY CHECKED BY: GARY SANTY
RAMP D CROSS SECTIONS DX-06 SHEET 327 OF 367

V:\953\active\9530002\transportation\drawing\confract\plot\files\z307c1xs_combined.prf