


NOTE:
FOR CLARITY, RAMP A CROSS SECTIONS HAVE BEEN
COMBINED WITH RAMP D CROSS SECTIONS. BE ADVISED
RAMP A SECTIONS ARE PERPENDICULAR TO RAMP D
ALIGNMENT. ALL OFFSETS SHOWN ARE FROM RAMP D.

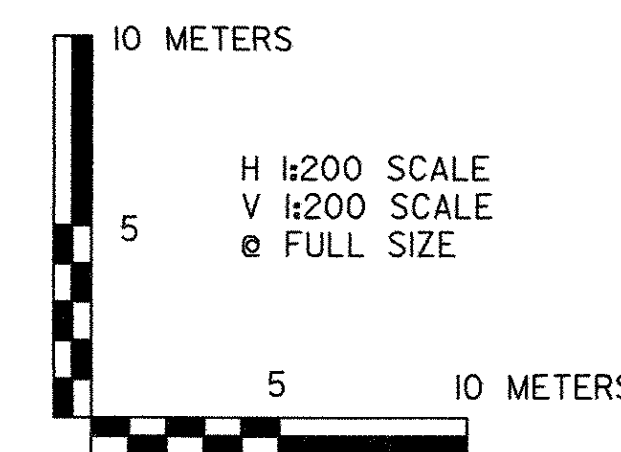

VERMONT AGENCY OF TRANSPORTATION

Stantec

PROJECT NAME: BENNINGTON
PROJECT NUMBER: AC NH 019-(51)

FILE NAME: ...zd307cixs.combined.ptf
DESIGN SUPERVISOR: GREG EDWARDS
DESIGNED BY: MARC FOISY

PLOT DATE: 1/29/2009
DRAWN BY: STANTEC
CHECKED BY: GARY SANTY

RAMP D CROSS SECTIONS DX-07 SHEET 328 OF 367

vr:\953\active\9530002\transportation\drawing\contract\plot_files\zd307cixs.combined.ptf