



D 1+380.000 = A 1+373.449

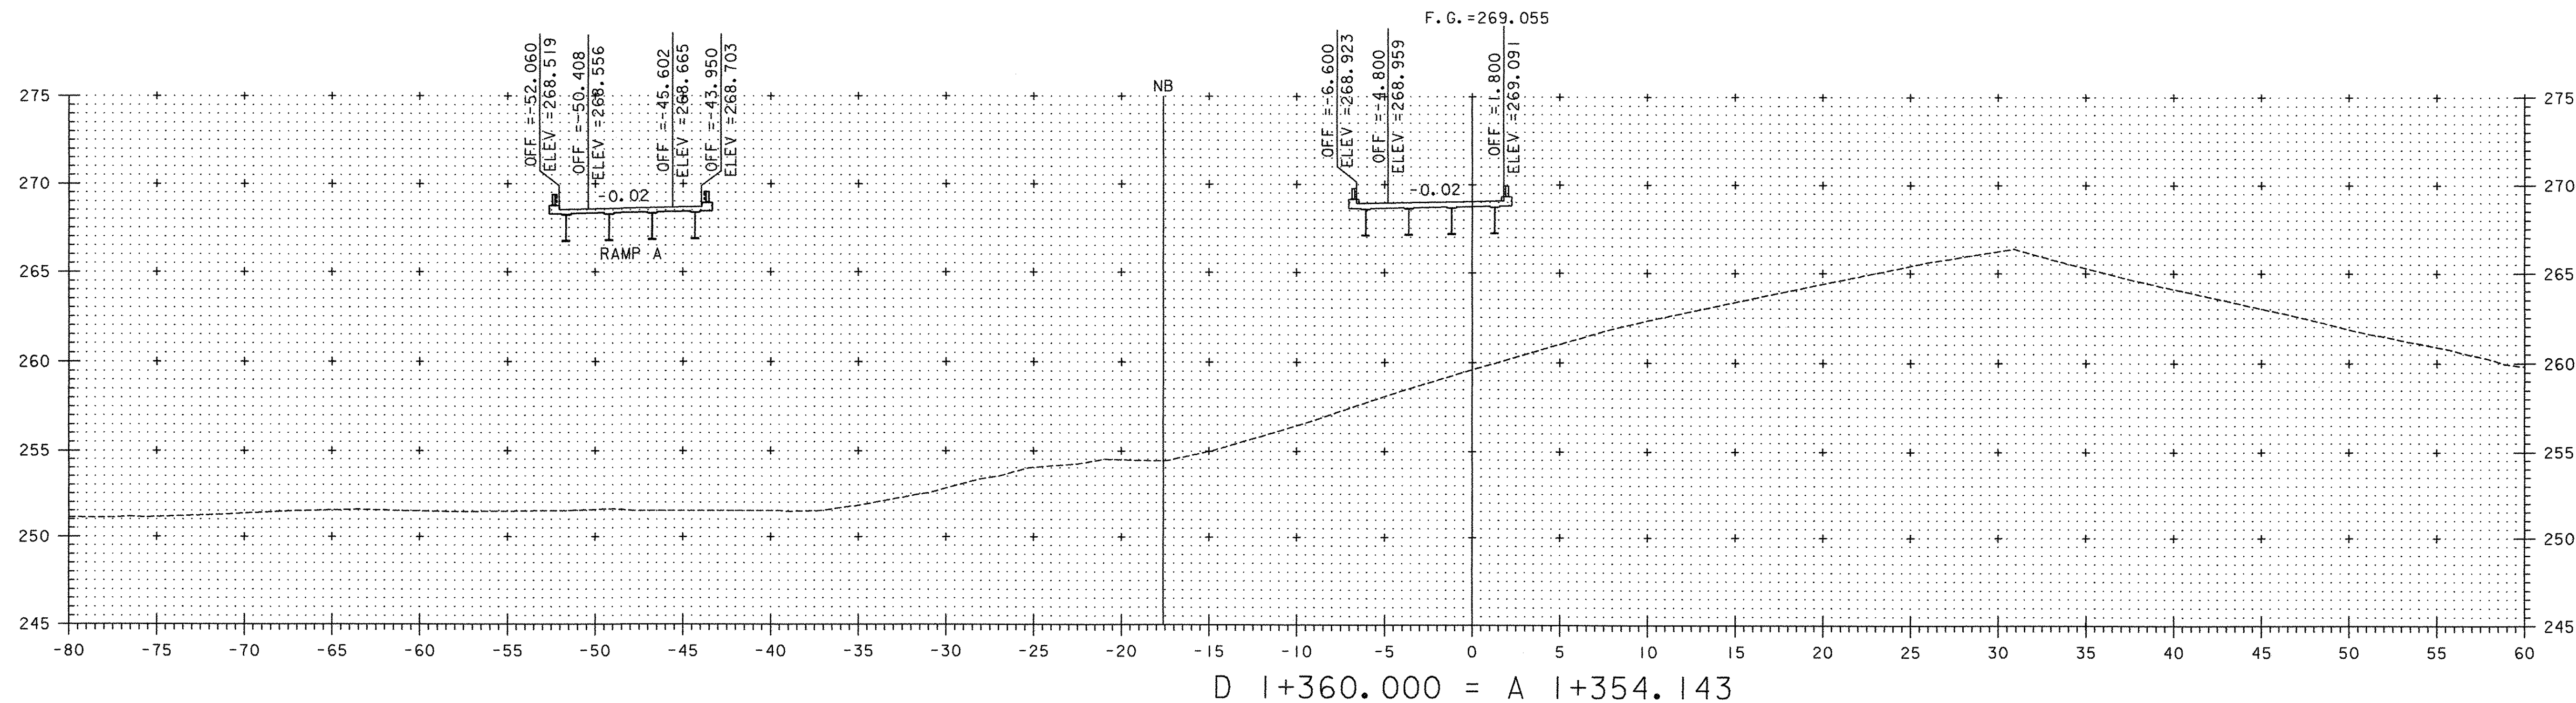

D 1+360.000 = A 1+354.143

NOTE:
FOR CLARITY, RAMP A CROSS SECTIONS HAVE BEEN
COMBINED WITH RAMP D CROSS SECTIONS. BE ADVISED
RAMP A SECTIONS ARE PERPENDICULAR TO RAMP D
ALIGNMENT. ALL OFFSETS SHOWN ARE FROM RAMP D.

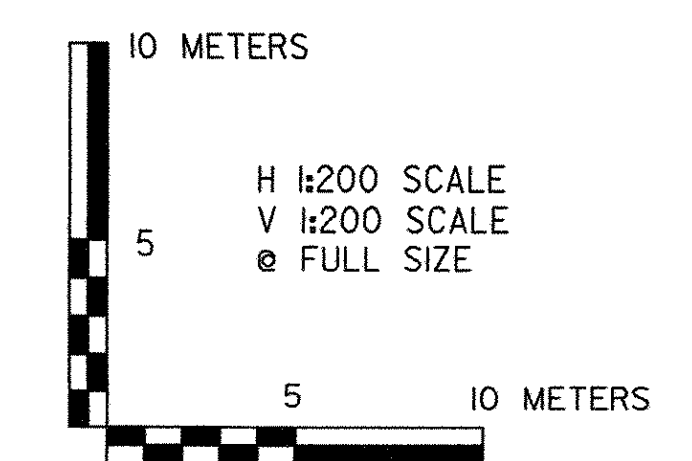

VERMONT AGENCY OF TRANSPORTATION	
	PROJECT NAME: BENNINGTON
	PROJECT NUMBER: AC NH 019-(51)
DESIGN SUPERVISOR: GREG EDWARDS	PLOT DATE: 1/29/2009
DESIGNED BY: MARC FOISY	DRAWN BY: STANTEC
RAMP D CROSS SECTIONS DX-09	CHECKED BY: GARY SANTY
	SHEET 330 OF 367

V:\953\active\953\0002\transportation\drawing\contract\plot files\dx307cxs_combined.prf