



NOTE:
FOR CLARITY, RAMP A CROSS SECTIONS HAVE BEEN COMBINED WITH RAMP D CROSS SECTIONS. BE ADVISED RAMP A SECTIONS ARE PERPENDICULAR TO RAMP D ALIGNMENT. ALL OFFSETS SHOWN ARE FROM RAMP D.



VERMONT AGENCY OF TRANSPORTATION

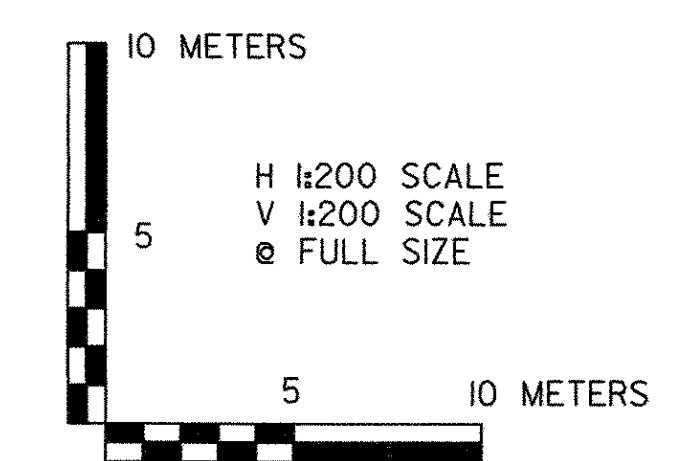

PROJECT NAME: BENNINGTON	PLOT DATE: 1/29/2009
PROJECT NUMBER: AC NH 019-1(51)	DRAWN BY: STANTEC
FILE NAME: ...zd307c1xs_combined.p1f	CHECKED BY: GARY SANTY
DESIGN SUPERVISOR: GREG EDWARDS	SHEET 331 OF 367
DESIGNED BY: MARC FOISY	

RAMP D CROSS SECTIONS DX-10

Y:\9553\active\18530002\transportation\drawing\contract\plot files\z307c1xs_combined.p1f