


NOTE:  
 FOR CLARITY, RAMP A CROSS SECTIONS HAVE BEEN  
 COMBINED WITH RAMP D CROSS SECTIONS. BE ADVISED  
 RAMP A SECTIONS ARE PERPENDICULAR TO RAMP D  
 ALIGNMENT. ALL OFFSETS SHOWN ARE FROM RAMP D.

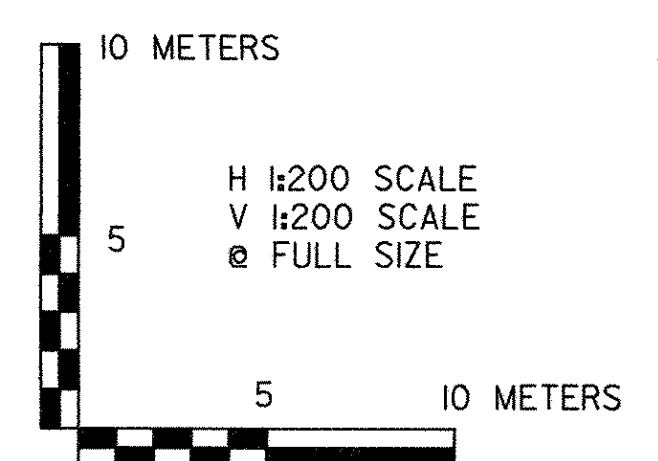

|   |                        |
|---|------------------------|
| <b>VERMONT AGENCY OF TRANSPORTATION</b> |                        |
|   |                        |
| PROJECT NAME: BENNINGTON                | PLOT DATE: 1/29/2009   |
| PROJECT NUMBER: AC NH 019-1(51)         | DRAWN BY: STANTEC      |
| FILE NAME: ...vzd307clxs_combined.ptf   | CHECKED BY: GARY SANTY |
| DESIGN SUPERVISOR: GREG EDWARDS         | SHEET 334 OF 367       |
| DESIGNED BY: MARC FOISY                 |                        |
| <b>RAMP D CROSS SECTIONS DX-13</b>      |                        |

V:\1953\active\19530002\transportation\drawing\cont\road\plot\_files\z307clxs\_combined.up1.f