


NOTE:  
SEE SHEETS VTX 18-24  
FOR DRIVE DETAILS

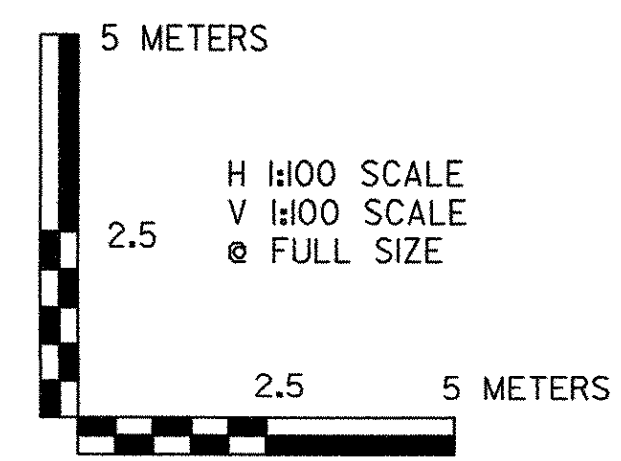

<b>VERMONT AGENCY OF TRANSPORTATION</b>	
	PROJECT NAME: BENNINGTON
	PROJECT NUMBER: AC NH 019-(K51)
DESIGN SUPERVISOR: GREG EDWARDS	PLOT DATE: 1/29/2009
DESIGNED BY: MARC FOISY	DRAWN BY: STANTEC
<b>ROUTE 9 CROSS SECTIONS VTX-03</b>	CHECKED BY: GARY SANTY
	SHEET 339 OF 367

V:\1953\acfive\195310002\transportation\drawing\contract\plot files\zd307\dixs\_r19.plt