


NOTE:
SEE SHEETS VTX 18-24
FOR DRIVE DETAILS

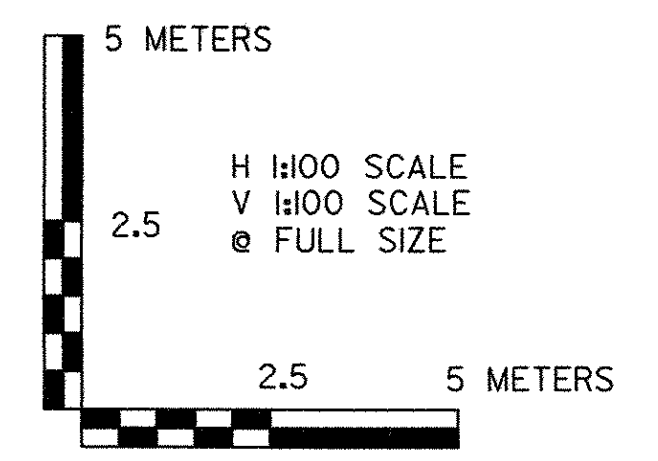

VERMONT AGENCY OF TRANSPORTATION	
	PROJECT NAME: BENNINGTON
	PROJECT NUMBER: AC NH 019-(K51)
FILE NAME: ...plot files\zd307\cls_r\9.prf	PLOT DATE: 1/29/2009
DESIGN SUPERVISOR: GREG EDWARDS	DRAWN BY: STANTEC
DESIGNED BY: MARC FOISY	CHECKED BY: GARY SANTY
ROUTE 9 CROSS SECTIONS VTX-05	
SHEET 341 OF 367	

v:\953\active\9530002\transportation\drawing\contract-1\plot_files\zd307\cls_r\9.prf