


NOTE:
SEE SHEETS VTX 18-24
FOR DRIVE DETAILS

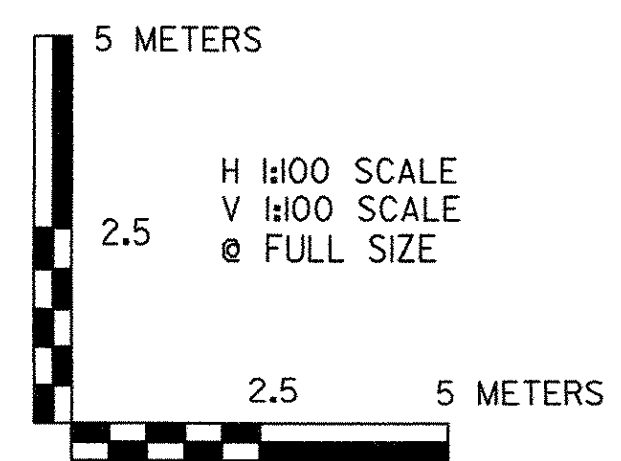

VERMONT AGENCY OF TRANSPORTATION	
	PROJECT NAME: BENNINGTON
	PROJECT NUMBER: AC NH 019-1(51)
FILE NAME: ...plot files\zd307cxs_r19.ptf	PLOT DATE: 1/29/2009
DESIGN SUPERVISOR: GREG EDWARDS	DRAWN BY: STANTEC
DESIGNED BY: MARC FOISY	CHECKED BY: GARY SANTY
ROUTE 9 CROSS SECTIONS VTX-06	
SHEET 342 OF 367	

v:\953\active\95310002\transportation\drawing\contract\plot_files\zd307cxs_r19.plt