


NOTE:
SEE SHEETS VTX 18-24
FOR DRIVE DETAILS



VERMONT AGENCY OF TRANSPORTATION

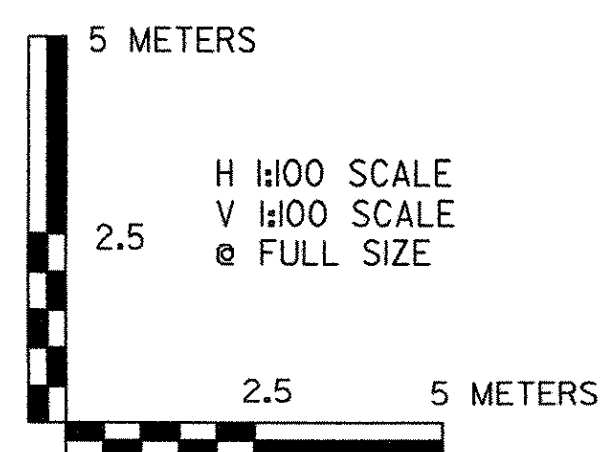

PROJECT NAME: BENNINGTON
 PROJECT NUMBER: AC NH 019-1(51)
 FILE NAME: ...plot files\zd307cixs.r19.ppf PLOT DATE: 1/29/2009
 DESIGN SUPERVISOR: GREG EDWARDS DRAWN BY: STANTEC
 DESIGNED BY: MARC FOISY CHECKED BY: GARY SANTY
ROUTE 9 CROSS SECTIONS VTX-08 SHEET 344 OF 367

V:\1953\active\1953\0002\transportation\drawing\contract\plot_files\zd307cixs.r19.ppf