


NOTE:
SEE SHEETS VTX 18-24
FOR DRIVE DETAILS



VERMONT AGENCY OF TRANSPORTATION

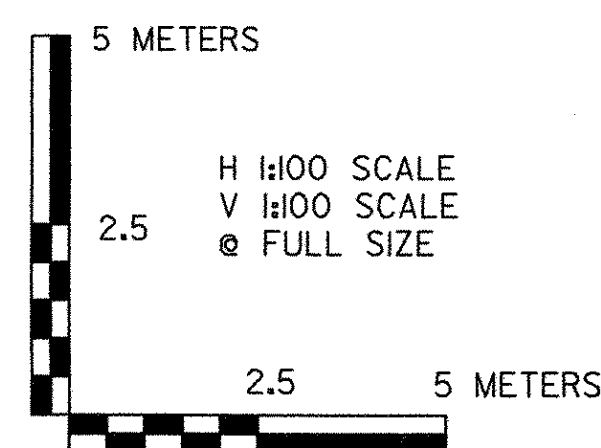

PROJECT NAME: BENNINGTON
PROJECT NUMBER: AC NH 019-1(51)

FILE NAME: ...plot files\zd307clxs.r19.p1f PLOT DATE: 1/29/2009
DESIGN SUPERVISOR: GREG EDWARDS DRAWN BY: STANTEC
DESIGNED BY: MARC FOISY CHECKED BY: GARY SANTY
ROUTE 9 CROSS SECTIONS VTX-09 SHEET 345 OF 367