


NOTE:  
SEE SHEETS VTX 18-24  
FOR DRIVE DETAILS

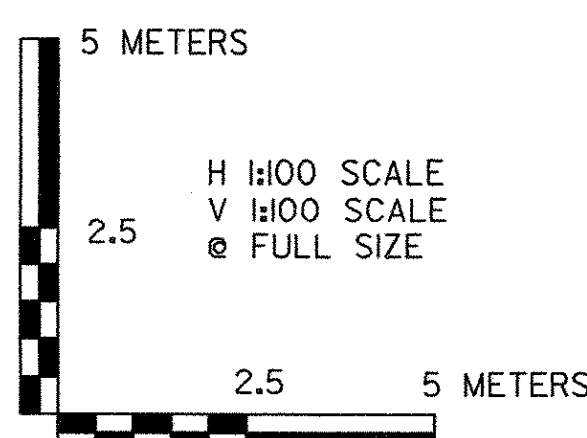

<b>VERMONT AGENCY OF TRANSPORTATION</b>	
	PROJECT NAME: BENNINGTON
	PROJECT NUMBER: AC NH 019-(51)
FILE NAME: ...\\plot_files\zd307c\xs.r19.ptf	PLOT DATE: 1/29/2009
DESIGN SUPERVISOR: GREG EDWARDS	DRAWN BY: STANTEC
DESIGNED BY: MARC FOISY	CHECKED BY: GARY SANTY
<b>ROUTE 9 CROSS SECTIONS VTX-10</b>	
SHEET 346 OF 367	

vt:\953\active\9530002\transportation\drawing\contract\plot\_files\zd307c\xs.r19.ptf