


NOTE:  
SEE SHEETS VTX 18-24  
FOR DRIVE DETAILS



VERMONT AGENCY OF TRANSPORTATION

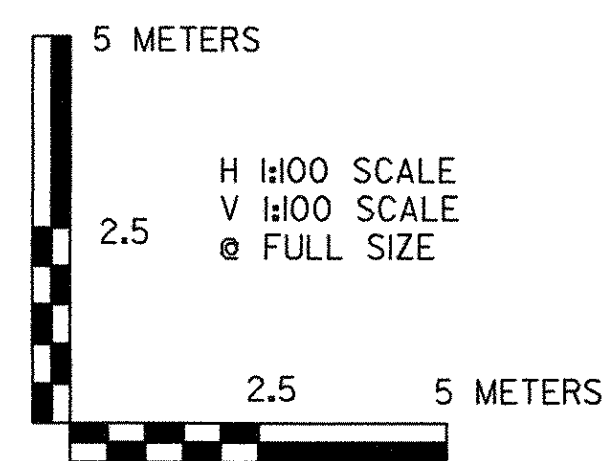

PROJECT NAME: BENNINGTON  
 PROJECT NUMBER: AC NH 019-1(51)  
 FILE NAME: ...\\plot\_files\zd307c\cx\_r19.pff PLOT DATE: 1/29/2009  
 DESIGN SUPERVISOR: GREG EDWARDS DRAWN BY: STANTEC  
 DESIGNED BY: MARC FOISY CHECKED BY: GARY SANTY  
**ROUTE 9 CROSS SECTIONS VTX-11** SHEET 347 OF 367

V:\1853\active\1853\002\transportation\drawing\contract\contract\_19.p1f