


NOTE:
SEE SHEETS VTX 18-24
FOR DRIVE DETAILS

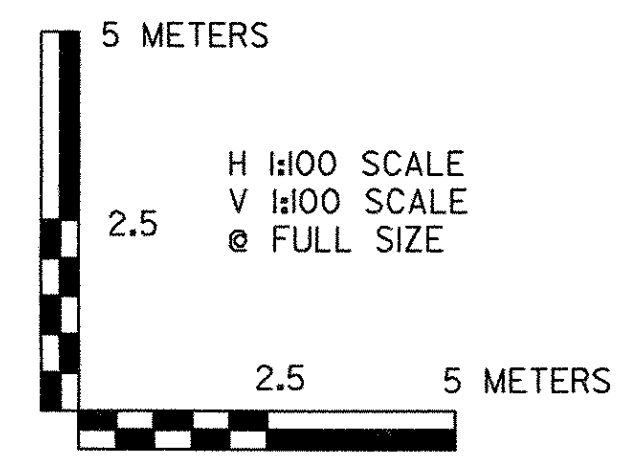

VERMONT AGENCY OF TRANSPORTATION	
	PROJECT NAME: BENNINGTON
	PROJECT NUMBER: AC NH 019-(K51)
FILE NAME: ...plot files\zd307\dxs_r19.prf	PLOT DATE: 1/29/2009
DESIGN SUPERVISOR: GREG EDWARDS	DRAWN BY: STANTEC
DESIGNED BY: MARC FOISY	CHECKED BY: GARY SANTY
ROUTE 9 CROSS SECTIONS VTX-13	
SHEET 349 OF 367	

v:\953\active\19530002\transportation\drawing\contract\plot files\zd307\dxs_r19.prf