


NOTE:
SEE SHEETS VTX 18-24
FOR DRIVE DETAILS

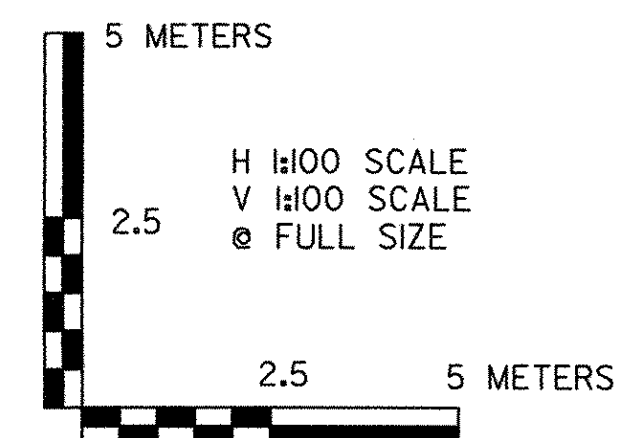

VERMONT AGENCY OF TRANSPORTATION

| | |
|--|------------------------|
| PROJECT NAME: BENNINGTON | PLOT DATE: 1/29/2009 |
| PROJECT NUMBER: AC NH 019-1(51) | DRAWN BY: STANTEC |
| FILE NAME: ...plot files\zd307c\ks_r19.prf | CHECKED BY: GARY SANTY |
| DESIGN SUPERVISOR: GREG EDWARDS | SHEET 351 OF 367 |
| DESIGNED BY: MARC FOISY | |

ROUTE 9 CROSS SECTIONS VTX-15

W:\953\active\9531002\transportation\drawing\centr\cst\1\plot_files\zd307c\ks_r19.prf