


NOTE:
SEE SHEETS VTX 18-24
FOR DRIVE DETAILS

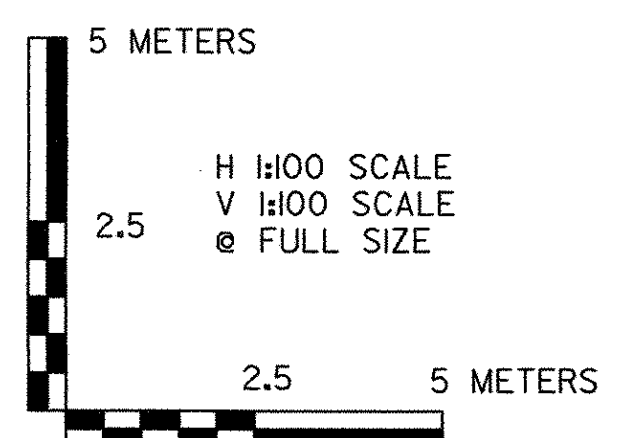

| | |
|--|---------------------------------|
| VERMONT AGENCY OF TRANSPORTATION | |
| | PROJECT NAME: BENNINGTON |
| | PROJECT NUMBER: AC NH 019-1(51) |
| FILE NAME: ...plot files\zd307c\vs_r+9.ptf | PLOT DATE: 1/29/2009 |
| DESIGN SUPERVISOR: GREG EDWARDS | DRAWN BY: STANTEC |
| DESIGNED BY: MARC FOISY | CHECKED BY: GARY SANTY |
| ROUTE 9 CROSS SECTIONS VTX-16 | |
| SHEET 352 OF 367 | |

V:\953\active\18538002\transportation\drawing\contract\plot files\zd307c\vs_r+9.ptf