


V:\1953\active\1953\0002\transportation\drawing\contract\plot_files\z307cxs_nb.ppf



VERMONT AGENCY OF TRANSPORTATION

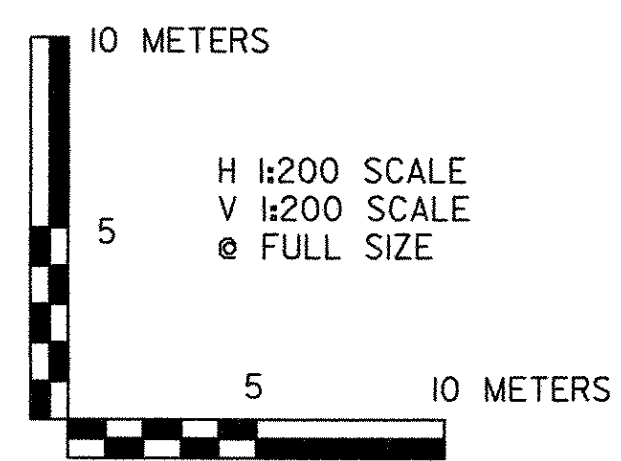

PROJECT NAME: BENNINGTON
 PROJECT NUMBER: AC NH 019-1(51)

FILE NAME: ...plot_files\z307cxs_nb.ppf PLOT DATE: 1/29/2009
 DESIGN SUPERVISOR: GREG EDWARDS DRAWN BY: STANTEC
 DESIGNED BY: MARC FOISY CHECKED BY: GARY SANTY
NB MAINLINE CROSS SECTIONS NBX-01 SHEET 361 OF 367