



NB 7+220

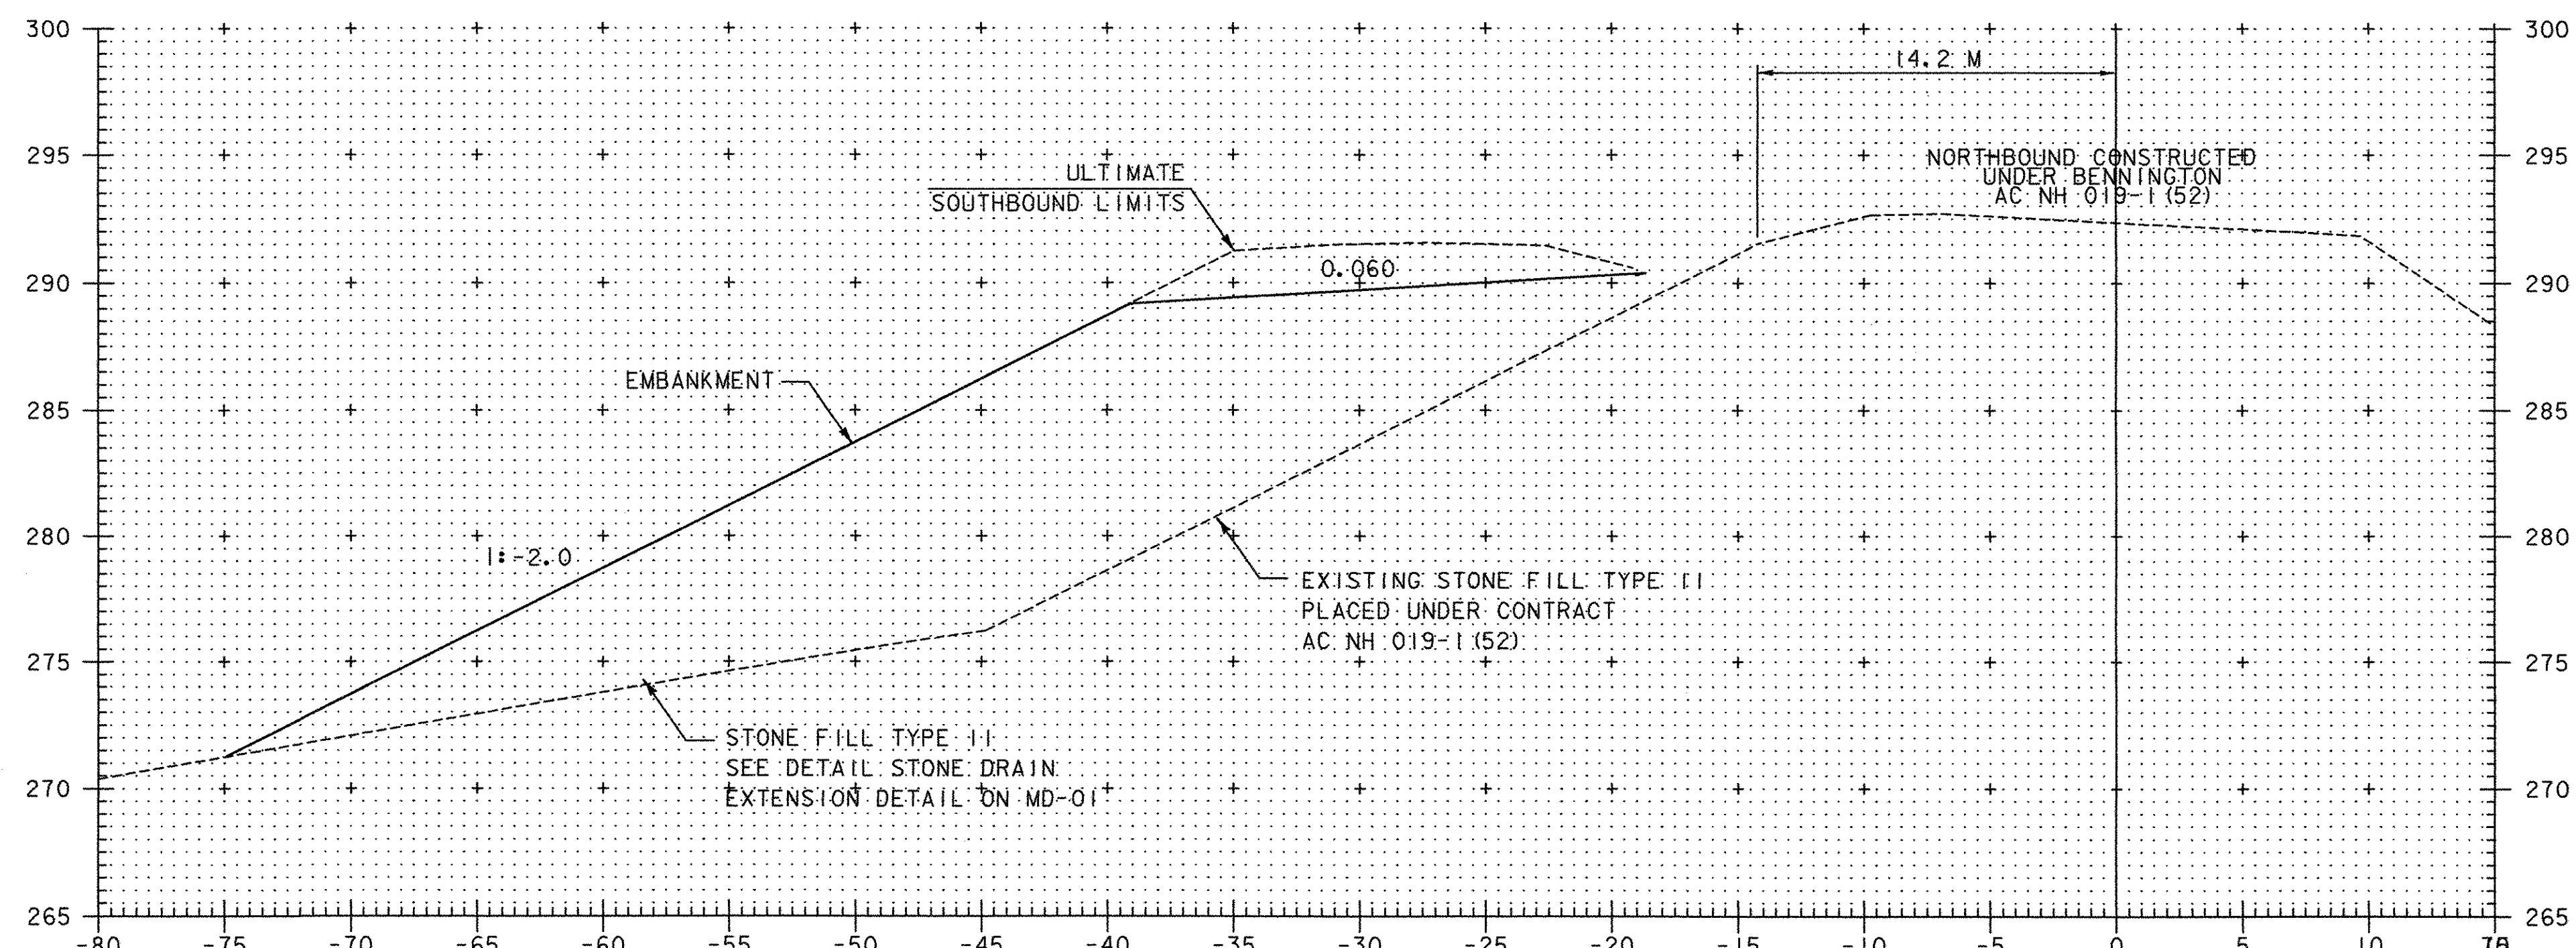

NB 7+200

vr:\953\active\9530002\transportation\drawing\contract\ndplot_files\zd307cxs_nb.pft

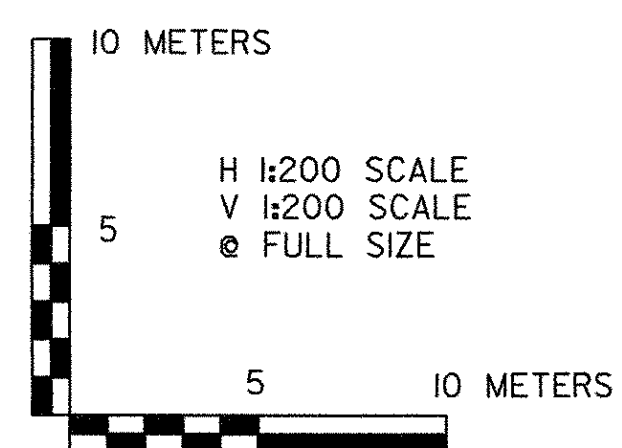

VERMONT AGENCY OF TRANSPORTATION



PROJECT NAME: BENNINGTON
PROJECT NUMBER: AC NH 019-1(51)

FILE NAME: ...plot_files\zd307cxs_nb.pft PLOT DATE: 2/2/2009
DESIGN SUPERVISOR: GREG EDWARDS DRAWN BY: STANTEC
DESIGNED BY: MARC FOISY CHECKED BY: GARY SANTY
NB MAINLINE CROSS SECTIONS NBX-04 SHEET 364 OF 367