



NB 7+300

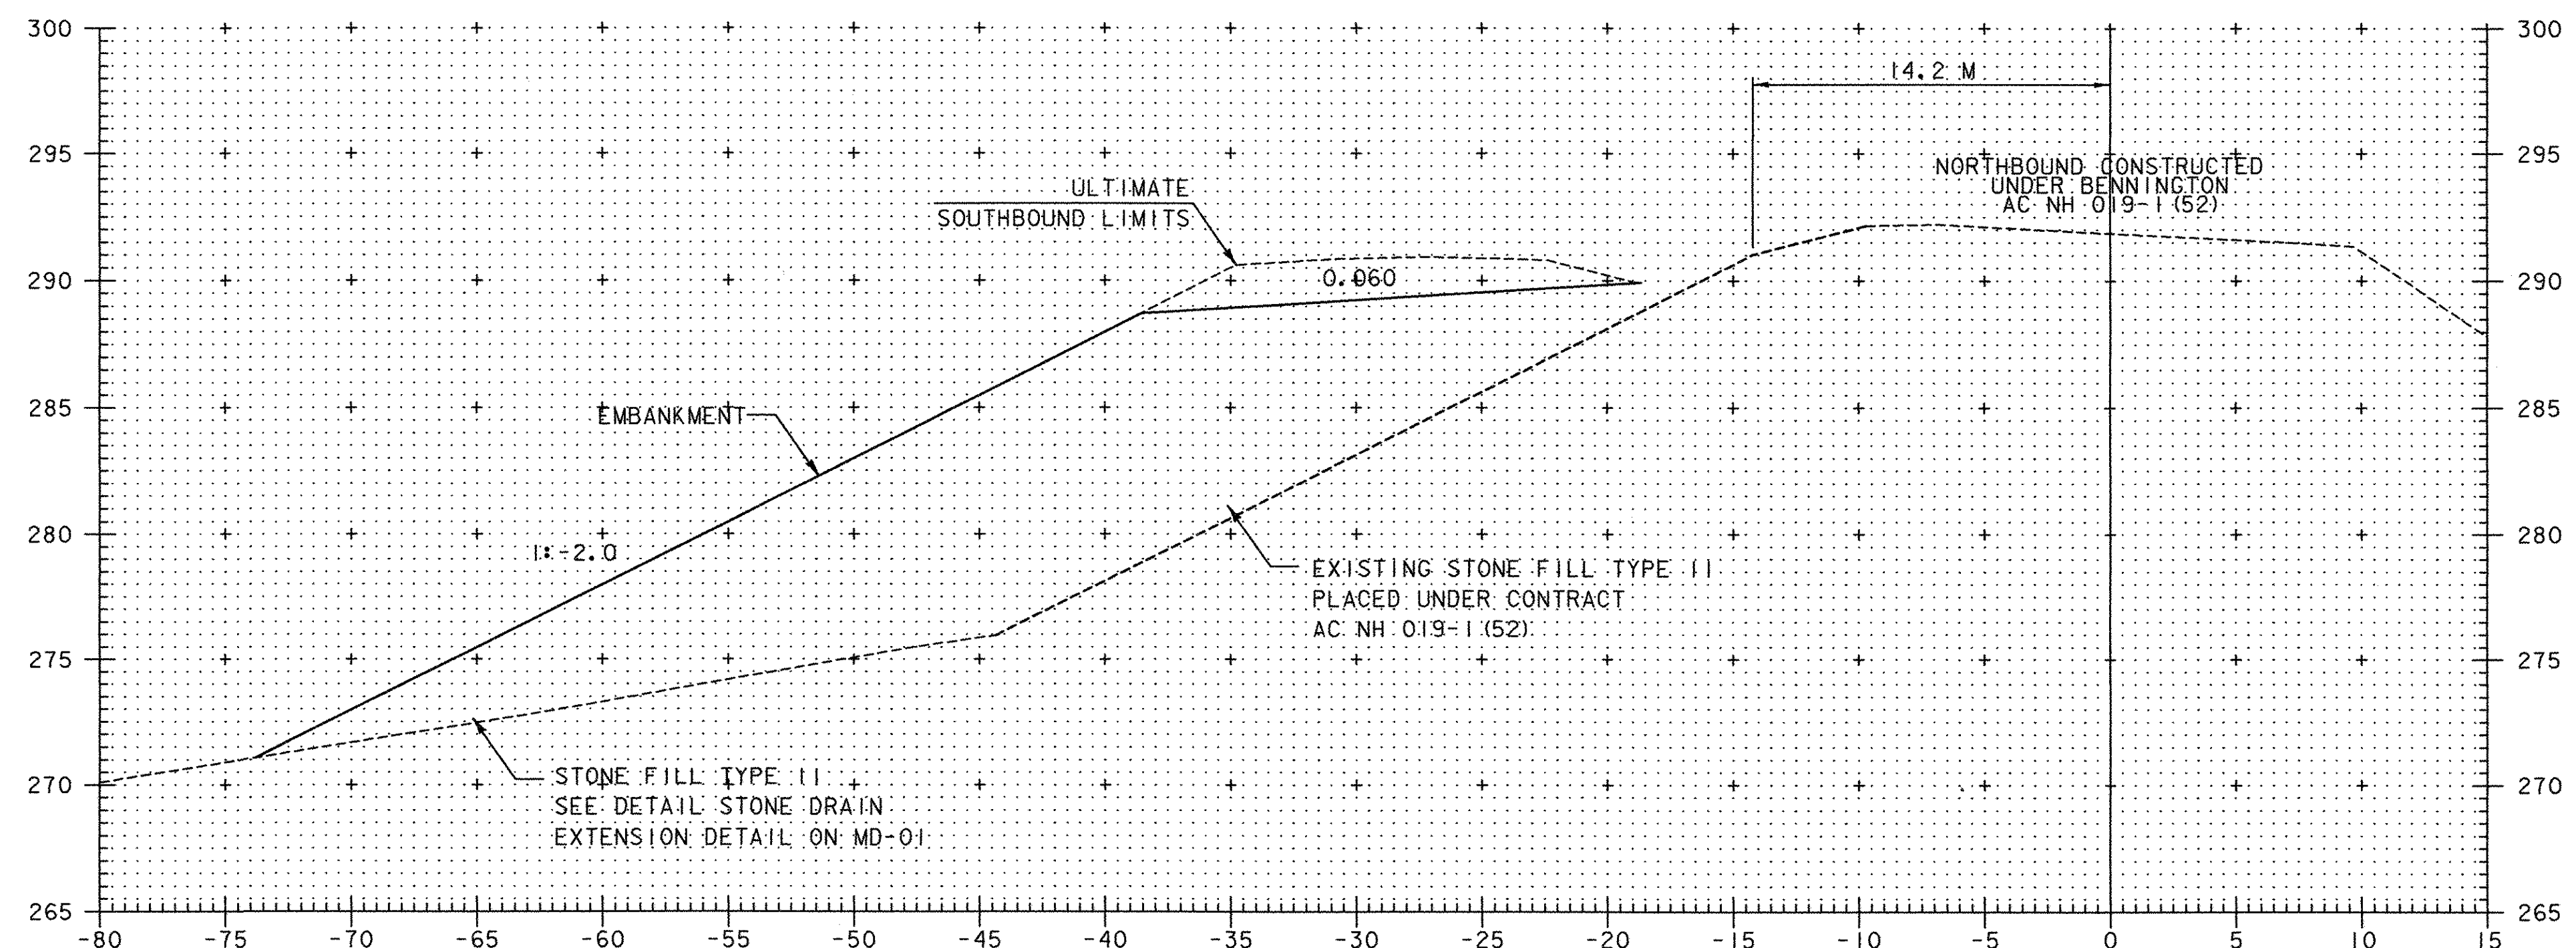

NB 7+280

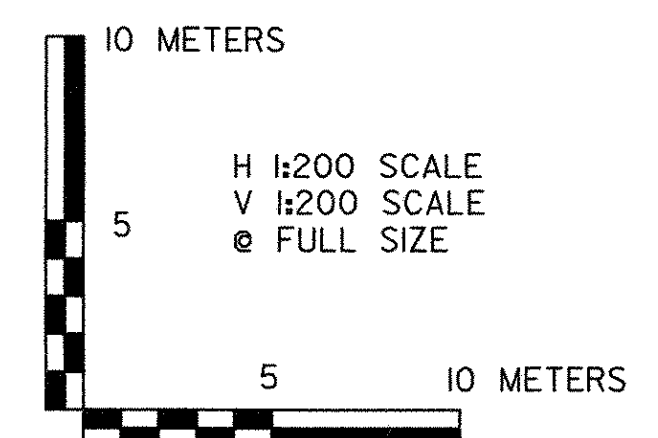

VERMONT AGENCY OF TRANSPORTATION	
	PROJECT NAME: BENNINGTON PROJECT NUMBER: AC NH 019-1(51)
	FILE NAME: ...plot files\zd307clxs_nb.ptf PLOT DATE: 2/2/2009 DESIGN SUPERVISOR: GREG EDWARDS DRAWN BY: STANTEC DESIGNED BY: MARC FOISY CHECKED BY: GARY SANTY NB MAINLINE CROSS SECTIONS NBX-06 SHEET 366 OF 367

v:\953\active\95310002\transportation\drawing\contract_plot_files\zd307clxs_nb.ptf